


Give All Information Completely
Make Required Affidavit
Mail or Deliver Report to:
Conservation Division
State Corporation Commission
P. O. Box 17027
Wichita, Kansas 67217
NORTH

WELL PLUGGING RECORD

Logan County, Sec. 24 Twp. 11S Rge. 33W (E) (W)

Location as "NE/CNWxSWx" or footage from lines SE SE SW
Lease Owner DONALD C. SLAWSON
Lease Name KUHLMAN 'H' Well No. 1
Office Address 200 Douglas Building Wichita, Kansas 67202
Character of Well (completed as Oil, Gas or Dry Hole) Dry Hole
Date well completed January 9, 1982
Application for plugging filed January 9, 1982
Application for plugging approved January 9, 1982
Plugging commenced January 9, 1982
Plugging completed January 9, 1982
Reason for abandonment of well or producing formation Dry Hole

If a producing well is abandoned, date of last production 19
Was permission obtained from the Conservation Division or its agents before plugging was commenced? Yes

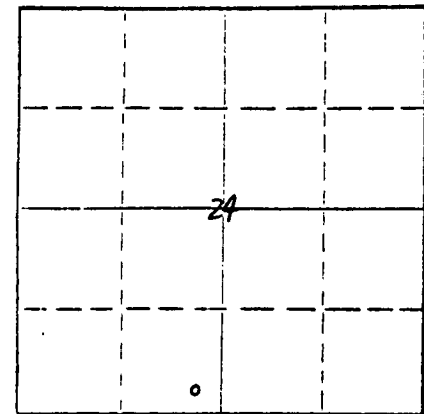

Locate well correctly on above Section Plat

Name of Conservation Agent who supervised plugging of this well Carl Goodrow
Producing formation _____ Depth to top _____ Bottom _____ Total Depth of Well 4750 Feet
Show depth and thickness of all water, oil and gas formations.

OIL, GAS OR WATER RECORDS

CASING RECORD

FORMATION	CONTENT	FROM	TO	SIZE	PUT IN	PULLED OUT
		surface	336'	8 5/8"		

RECEIVED
STATE CORPORATION COMMISSION
2-24-1982
FEB 24 1982


Describe in detail the manner in which the well was plugged, indicating where the mud fluid was placed and the method or methods used in introducing it into the hole. If cement or other plugs were used, state the character of same and depth placed, from _____ feet to _____ feet for each plug set.

1st plug @ 1650' w/70 sx
2nd plug @ 350' w/40 sx
Top plug @ 40' w/10 sx
10 sx in Rat Hole

Name of Plugging Contractor Sun Oil Well Cementing, Inc.
Address Box 169 Great Bend, Kansas 67530

STATE OF KANSAS COUNTY OF SEDGWICK ss.
William R. Horgan

(employee of owner) or (owner or operator) of the above-described well, being first duly sworn on oath, says: That I have knowledge of the facts, statements, and matters herein contained and the log of the above-described well as filed and that the same are true and correct. So help me God.

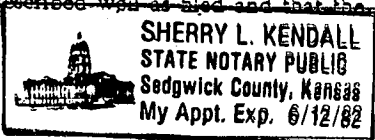

(Signature) William R. Horgan, Operations Engineer

200 Douglas Bldg. (Address) Wichita, Kansas 67202

SUBSCRIBED AND SWORN TO before me this 16th day of February, 1982

Sherry L. Kendall
Notary Public.

My commission expires 06/12/82