


Give All Information Completely
Make Required Affidavit
Mail or Deliver Report to:
Conservation Division
State Corporation Commission
211 No. Broadway
Wichita, Kansas

WELL PLUGGING RECORD

Ellis County, Sec. 1 Twp. 11S Rge. 16 (E) (W)

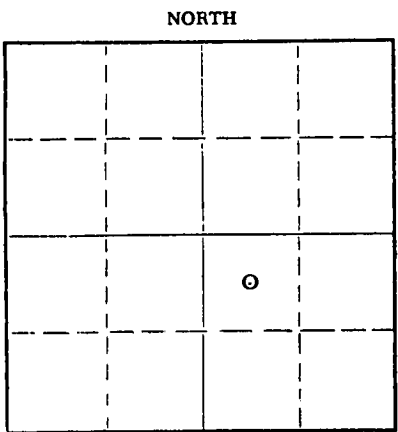

Location as "NE/CNW/SW" or footage from lines C NW SE
Lease Owner Rains & Williamson Oil Co.
Lease Name BOWLBY Well No. 1
Office Address 412 Union Center - Wichita, Kansas
Character of Well (completed as Oil, Gas or Dry Hole) Dry Hole
Date well completed 3-14 19 63
Application for plugging filed 3-14 19 63
Application for plugging approved 3-14 19 63
Plugging commenced 3-14 19 63
Plugging completed 3-14 19 63
Reason for abandonment of well or producing formation No oil or gas found in commercial quantities

If a producing well is abandoned, date of last production ----- 19--
Was permission obtained from the Conservation Division or its agents before plugging was commenced? Yes

Name of Conservation Agent who supervised plugging of this well Eldon Petty, Hays, Kansas
Producing formation NONE Depth to top ----- Bottom ----- Total Depth of Well 3520 Feet
Show depth and thickness of all water, oil and gas formations.

OIL, GAS OR WATER RECORDS

CASING RECORD

FORMATION	CONTENT	FROM	TO	SIZE	PUT IN	PULLED OUT
				8-5/8"	150'	NONE

Describe in detail the manner in which the well was plugged, indicating where the mud fluid was placed and the method or methods used in introducing it into the hole. If cement or other plugs were used, state the character of same and depth placed, from _____ feet to _____ feet for each plug set.

Set first plug at 450 feet and cemented through drill pipe with 20 sacks cement. Filled hole with rotary mud to 180 feet. Set second plug at 180 feet. Cemented through drill pipe with 20 sacks cement. Filled hole with rotary mud to 40' of base of cellar. Capped with 10 sacks cement.

RECEIVED
STATE CORPORATION COMMISSION
3-19-63
MAR 19 1963

CONSERVATION DIVISION
Wichita, Kansas

(If additional description is necessary, use BACK of this sheet)
Name of Plugging Contractor Rains & Williamson Oil Co.
Address 412 Union Center - Wichita, Kansas

STATE OF KANSAS, COUNTY OF SEDGWICK, ss.
Wilson Rains - Partner

(owner or operator) of the above-described well, being first duly sworn on oath, says: That I have knowledge of the facts, statements, and matters herein contained and the log of the above-described well as filed and that the same are true and correct. So help me God.

(Signature) Wilson Rains Wilson Rains
412 Union Center - Wichita, Kansas
(Address)

SUBSCRIBED AND SWORN to before me this 18th day of March, 19 63

My commission expires November 8, 1966
Sherry Gish
Sherry Gish Notary Public.

ROTARY DRILLING LOG

OPERATOR: Rains & Williamson Oil Co.
 #1 BOWLBY
 C NW SE Sec. 1-11S-16W
 Ellis County, Kansas

CONTRACTOR: Rains & Williamson
 COMMENCED: 3-4-63
 COMPLETED: 3-14-63

Remarks: Set 8-5/8" surface casing at 150' with 100 sacks quick cement.

FORMATIONS


Shale	355'
Shale and Sand	895'
Red Beds and Shale	975'
Shale and Shells	1092'
Anhydrite	1125'
Shale	1235'
Shale and Shells	1715'
Lime and Shale	2380'
Shale and Lime	2560'
Shale and Lime Streaks	2745'
Lime and Shale	2935'
Lime	3448'
Conglomerate - Chert	3465'
Lime	3474'
Lime and Chert	3520'
Rotary Total Depth (D & A)	3520'

We certify the above log is true and correct to the best of our knowledge and belief.

RAINS & WILLIAMSON OIL CO.


 Wilson Rains
 Partner

Subscribed and sworn to before me,
 a Notary Public in and for the State
 of Kansas, County of Sedgwick, this
 18th day of March, 1963.

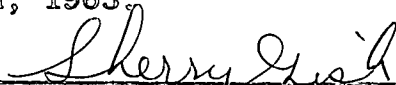
 Sherry Gish - Notary Public

My Commission Expires:
November 8, 1966

RECEIVED
 STATE CORPORATION COMMISSION

MAR 19 1963

CONSERVATION DIVISION
 Wichita, Kansas