


Give All Information Completely
Make Required Affidavit
Mail or Deliver Report to:
Conservation Division
State Corporation Commission
800 Bitting Building
Wichita, Kansas

WELL PLUGGING RECORD

NORTH

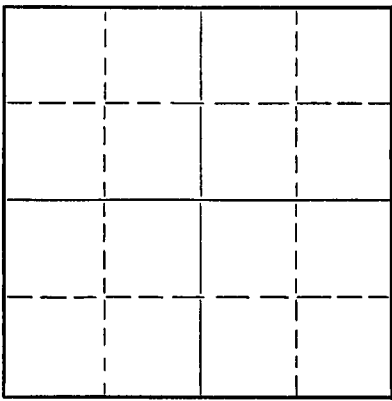

Locate well correctly on above
Section Plat

Ellis County. Sec. 1 Twp. 11 Rge. 16 (E) (W)
 Location as "NE/CNW $\frac{1}{4}$ SW $\frac{1}{4}$ " or footage from lines 2310'N 330'E of SW Corner
 Lease Owner Cities Service Oil Co.
 Lease Name Bowlby "C" Well No. 1
 Office Address Bartlesville, Oklahoma
 Character of Well (completed as Oil, Gas or Dry Hole) DRY
 Date well completed 6/1/52 19
 Application for plugging filed 6/1/52 19
 Application for plugging approved 6/2/52 19
 Plugging commenced 6/2/52 19
 Plugging completed 6/3/52 19
 Reason for abandonment of well or producing formation.....

If a producing well is abandoned, date of last production..... 19
 Was permission obtained from the Conservation Division or its agents before plugging was commenced?..... yes

Name of Conservation Agent who supervised plugging of this well..... Mr. Eldon Petty
 Producing formation..... Depth to top 327 Bottom..... Total Depth of Well 3510 Feet
 Show depth and thickness of all water, oil and gas formations.

OIL, GAS OR WATER RECORDS

CASING RECORD

Formation	Content	From	To	Size	Put In	Pulled Out
<u>Lansing-Kansas City</u>				<u>8-5/8</u>	<u>277'</u>	<u>0</u>

Describe in detail the manner in which the well was plugged, indicating where the mud fluid was placed and the method or methods used in introducing it into the hole. If cement or other plugs were used, state the character of same and depth placed, from.....feet to.....feet for each plug set.

Filled with heavy mud to 265', set plug, run 15 sacks of cement on plug through drill pipe. Filled with mud to 40', set plug with 2 sack hulls on plug, ran 10 sacks cement to surface.

(If additional description is necessary, use BACK of this sheet)

Name of Plugging Contractor..... Holm Drilling Co.
 Address..... Tulsa, Oklahoma

STATE OF KANSAS, COUNTY OF BARTON, SS.
James Porter (employee of owner) or (owner/operator) of the above-described well,
 being first duly sworn on oath, says: That I have knowledge of the facts, statements, and matters herein contained and the log of the above-described well as filed and that the same are true and correct. So help me God.

(Signature) James Porter
 Box 553, Russell, Kansas
 (Address)

SUBSCRIBED AND SWORN to before me this 9th day of June, 1952
W. E. Smith Notary Public.

My commission expires 3-12-1955
 23-8390-s 6-51-20M

STATE CORPORATION COMMISSION
 6-25-52
 JUN 25 1952

PLUGGING
 WELL NO. LT 11162
 BOOK PAGE 201 38

CONSERVATION DIVISION
 Kansas
 CP-4

WELL RECORD

Company Cities Service Oil Co. Well No. 1 Farm Bowlby "C"
 Location 2310' North and 280' East of SW Corner Sec. 1 T. 11 R. 16W
 Elevation 2020 (2017 Gr.) County Ellis State Kansas
 Drlg. Comm. May 21, 1952 Contractor Hola Drilling Company
 Drlg. Comp. June 1, 1952 Acid None
 T. D. 3510' Initial Prod. Dry Hole; P. & A. (6-2-52)

CASING RECORD:

2-5/8" @ 277' cen. 200 cc cement

FORMATION RECORD:

lime	0-40
shale	277
shale & shells	485
sand	570
shale & shells	925
red bed	1130
shale & shells	1225
anhydrite	1258
shale & shells	1490
salt, shale & shells	1585
shale & shells	1790
lime & shale	3510 T. D.

Topoka	2912'
Heebner	3172'
Dodge	3193'
Lansing	3217'
Penetration	293'
Total Depth	3510'

WFO:	500'	1°
	1000'	0°
	1500'	0°
	2000'	0°
	2500'	1°
	3000'	0°

D. S. T. 3265-80, open 1 hr., recovered 30' slightly oil-cut mud, trace free oil; D. S. T. 405/15 mins.

7-7/8" rotary hole.

D. S. T. 3313-24, open 1 hr., recovered 30' mud; D. S. T. 405/15 mins.

PLUGGING

FILE SEC LT 16 P 16

PAGE 20 OF 38