


STATE OF KANSAS
STATE CORPORATION COMMISSION

Give All Information Completely
Make Required Affidavit
Mail or Deliver Report to:
Conservation Division
State Corporation Commission
211 No. Broadway
Wichita, Kansas

WELL PLUGGING RECORD

NORTH

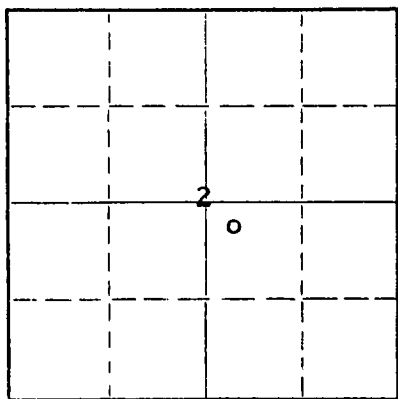

Locate well correctly on above
Section Plat

Rooks County. Sec. 2 Twp. 10S Rgd. 17W (E) (W)
Location as "NE/CNW/SW" or footage from lines NW NW SE
Lease Owner Murfin Drilling Co.
Lease Name Loreg Well No. 1
Office Address 617 Union Center - Wichita, Kansas
Character of Well (completed as Oil, Gas or Dry Hole) oil
Date well completed 8-12 1955
Application for plugging filed 11-29 1956
Application for plugging approved 11-30 1956
Plugging commenced 12-5 1956
Plugging completed 12-12 1956
Reason for abandonment of well or producing formation dry

If a producing well is abandoned, date of last production October 1956
Was permission obtained from the Conservation Division or its agents before plugging was commenced? yes

Name of Conservation Agent who supervised plugging of this well Eldon Petty
Producing formation Lansing KC Depth to top 3214 Bottom _____ Total Depth of Well 3537 Feet
Show depth and thickness of all water, oil and gas formations.

OIL, GAS OR WATER RECORDS

CASING RECORD

FORMATION	CONTENT	FROM	TO	SIZE	PUT IN	PULLED OUT
				8 5/8	181	none
				5 1/2	3234	2632.10'

Describe in detail the manner in which the well was plugged, indicating where the mud fluid was placed and the method or methods used in introducing it into the hole. If cement or other plugs were used, state the character of same and depth placed, from _____ feet to _____ feet for each plug set.

Plug back with sand to 3200. Dump 4 sx. cement.
Mud to 180', set 5' rock bridge. Mix & dump 15 sx. cement.
Mud to 35', set 5' rock bridge. Mix and dump 10 sx. cement to base of cellar.

(If additional description is necessary, use BACK of this sheet)

Name of Plugging Contractor Ace Pipe Pulling Co.
Address Great Bend, Kansas

STATE OF Kansas, COUNTY OF Sedgwick, ss.
W. R. Murfin (employee of owner) or (owner or operator) of the above-described well, being first duly sworn on oath, says: That I have knowledge of the facts, statements, and matters herein contained and the log of the above-described well as filed and that the same are true and correct. So help me God.

(Signature) W R Murfin
(Address) _____

SUBSCRIBED AND SWORN TO before me this 3rd day of January, 1957.

My commission expires 6-13-59.

Bett Spriggs
RECEIVED Notary Public.
STATE CORPORATION COMMISSION
1-4-57
JAN 4 1957
CONSERVATION DIVISION
Wichita, Kansas

PLUGGING
FILE SEC 2 T. 10 R. 17W
BOOK PAGE 120 LINE 42

WELL LOG

COMPANY **Murfin Drilling Company**

SEC. 2 T. 10S R. 17W

FARM **Loieg** NO. 1

LOC. NW NW SE


TOTAL DEPTH **3537'**

COMM. **8-1-55**

COMP. **8-12-55**

COUNTY **Rooks**
KANSAS

SHOT OR TREATED
CONTRACTOR **Murfin Drilling Company**

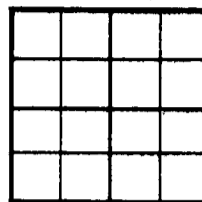

ISSUED

CASING

20 10
15 8 5/8" @ 181' w/120 sx.
12 6
13 5 1/2" @ 3532' w/100 sx.

ELEVATION **2063 DF**

PRODUCTION

FIGURES INDICATE BOTTOM OF FORMATIONS

30	Shale, sand
125	Shale
490	Shale, shells
833	Sandy shale
935	Shale, sand, shells
1045	Sand
1100	Redbed
1290	Shale sand
1334	Anhy.
1645	Shale, shells
1785	Salt, shale
1800	Shale, shells
1970	Shale, lime, shells
2955	Shale, lime
3321	Lime, shale
3423	Lime
3531	Lime, shale
3537	Lime (Arb.)
3537	RTD

TOPS: Anhy.	1290
Topeka	2951
Heebner	3172
Toronto	3193
LKC	3214
BKC	3458
T Congl.	3493
T Arb.	3531

DST #1 - 3212-55
Open 1 hr., shut in 20 min.
Rec. 10' heavy oil & gas cut mud, 90' oil & gas cut muddy wtr., 30' slightly oil & gas cut muddy wtr., 180' wtr.
BHP 1105#

DST #2 - 3262-90, Open 30 min. shut in 15; strong blow through out. Rec. 1710' gas, 30' heavy oil & gas cut mud; 240' glassy froggy oil. BHP 1040#

DST #3 - 3298-3321, Open 1 hr. Weak blow 3 min., rec. 10' mud w/few oil specks. BHP 0#

DST #4 - 3384-3427, Open 1 hr., weak blow 4 min., rec. 30' mud. BHP 0# in 15 min.

RECEIVED
STATE CORPORATION COMMISSION
RECORDS
CONSERVATION DIVISION
WELL LOGS

State of Kansas }
County of Sedgwick } SS:

I, W. R. Murfin of the Murfin Drilling Company

upon oath state that the above and foregoing is a true and correct copy of the log of the Loieg #1 well.

PLUGGING
FILE SEC. 2 T. 10 R. 17W
BOOK PAGE 120 LINE 42

W. R. Murfin

Subscribed and sworn to before me this 31st day of August 1955

My Commission Expires: 6-13-59

Betty Spriggs
NOTARY PUBLIC