

STATE OF KANSAS  
STATE CORPORATION COMMISSION

WELL PLUGGING RECORD

Give All Information Completely  
Make Required Affidavit  
Mail or Deliver Report to:  
Conservation Division  
State Corporation Commission  
800 Bitting Building  
Wichita, Kansas

Rooks County, Sec. 2 Twp. 10 Rge. 17 (E) (W)

Location as "NE/CNW $\frac{1}{4}$ SW $\frac{1}{4}$ " or footage from lines SW NW SW

Lease Owner Anschutz Drilling Company, Inc.

Lease Name Loreg Well No. 1

Office Address 709 Union Nat'l Bk Bldg., Wichita, Kansas

Character of Well (completed as Oil, Gas or Dry Hole) Dry Hole

Date well completed 6-8 19 52

Application for plugging filed 6-8 19 52

Application for plugging approved 6-8 19 52


Plugging commenced 6-8 19 52

Plugging completed 6-8 19 52

Reason for abandonment of well or producing formation Dry

If a producing well is abandoned, date of last production 19

Was permission obtained from the Conservation Division or its agents before plugging was commenced? Yes

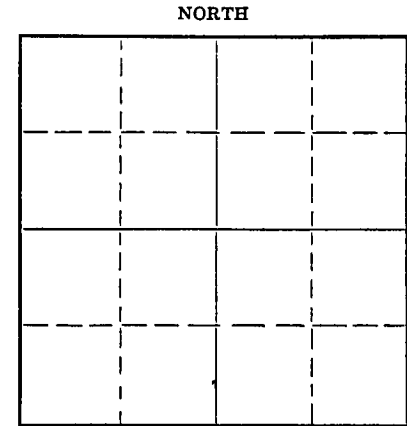

Locate well correctly on above  
Section Plat

Name of Conservation Agent who supervised plugging of this well Eldon Petty

Producing formation Depth to top Bottom Total Depth of Well 3502 Feet

Show depth and thickness of all water, oil and gas formations.

OIL, GAS OR WATER RECORDS

CASING RECORD

Formation	Content	From	To	Size	Put In	Pulled Out
				8-5/8"	177'	

Describe in detail the manner in which the well was plugged, indicating where the mud fluid was placed and the method or methods used in introducing it into the hole. If cement or other plugs were used, state the character of same and depth placed, from feet to feet for each plug set.

Top plug set at 30' with 10 sacks cement  
Bottom plug set at 160' with 15 sacks cement

(If additional description is necessary, use BACK of this sheet)

Name of Plugging Contractor Flounoy-Haston Drilling Company

Address Hoisington, Kansas

STATE OF KANSAS, COUNTY OF SEDGWICK, ss.  
Leon L. Mehler (employee of owner) or (owner or operator) of the above-described well,

being first duly sworn on oath, says: That I have knowledge of the facts, statements, and matters herein contained and the log of the above-described well as filed and that the same are true and correct. So help me God.

(Signature) Leon L. Mehler

709 Union Nat'l Bk Bldg., Wichita, Ks.  
(Address)

SUBSCRIBED AND SWORN TO before me this 12th day of June, 19 52

My commission expires May 2, 1956

Notary Public. Jacqueline Thomas

6-19-52

PLUGGING  
FILE SEC-2 T. 10 N. 7 W.  
INDEX PAGE 27 110

WELL LOG

Company Anschutz Drilling Co.  
Tools Flournoy-Haston Drilling Co.


#1 Loreg  
NW/4 SW/4 of  
Section 3-105-17W  
Rooks County, Kansas

GAISING 8/88" 172'

COMMENCED May 26, 1952 Cement 100 ex.  
COMPLETED June 7, 1952

FORMATION

Shale and Post Rock	40'
Post Rock and Sand	100'
Shale and Shells	265'
Blue Shale and Shells	610'
Red Bed and Shade	670'
Sand	730'
Shale and Shells	730'
Sand	850'
Shale Red Bed	950'
Red Bed	1125'
Anhydrite	1280'
Shale and Shells	1315'
Shale and Lime Shells	1752'
Lime	1855'
Lime and Shale	1918'
Shale	2090'
Shale and Shells	2615'
Shale and Lime	2767'
Lime and Shale	2840'
Broken Lime and Shale	2902'
Lime and Shale	2950'
Lime	3019'
Lime and Shale	3134'
Lime	3188'
Lime Conglomerate	3414'
Arbuckle	3486'
	3502'

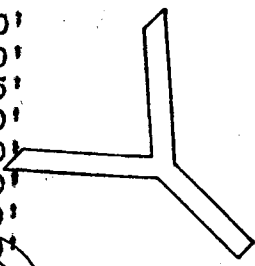

**RECEIVED**  
STATE CORPORATION COMMISSION  
JUN 12 1952  
CONSERVATION DIVISION  
Wichita, Kansas  
CERTIFICATION

I, C. D. Flournoy, certify that the above is a true and correct copy of the drillers log of the above well.

**PLUGGING**  
FILE SEC 2T10R170  
BOOK PAGE 27 LINE 60

RECEIVED  
STATE CORPORATION COMMISSION