

STATE OF KANSAS
STATE CORPORATION COMMISSION

WELL PLUGGING RECORD

Give All Information Completely
Make Required Affidavit
Mail or Deliver Report to:
Conservation Division
State Corporation Commission
800 Bitting Building
Wichita, Kansas

Ellis County, Sec. 3 Twp. 11 Rge. 16 (E) W (W)

Location as "NE/CNW/SW" or footage from lines NE/4 NE/4 NW/4

Lease Owner E.D. Bradstreet

Lease Name E.D. Bradstreet "Ramey" Well No. 1

Office Address 126 Grant St. Russell, Kansas.

Character of Well (completed as Oil, Gas or Dry Hole) Producer

Date well completed _____ 19__

Application for plugging filed _____ 19__

Application for plugging approved _____ 19__


Plugging commenced Feb. 8 19 54

Plugging completed Feb. 16 19 54

Reason for abandonment of well or producing formation _____

If a producing well is abandoned, date of last production _____ 19__

Was permission obtained from the Conservation Division or its agents before plugging was commenced? yes.

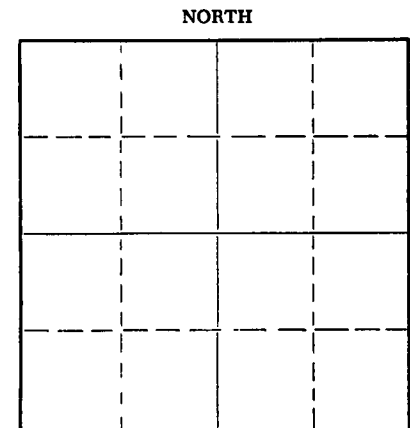

Locate well correctly on above Section Plat

Name of Conservation Agent who supervised plugging of this well Eldon Petty 3678

Producing formation _____ Depth to top _____ Bottom _____ Total Depth of Well 3237 Feet

Show depth and thickness of all water, oil and gas formations.

OIL, GAS OR WATER RECORDS

CASING RECORD

FORMATION	CONTENT	FROM	TO	SIZE	PUT IN	PULLED OUT

Describe in detail the manner in which the well was plugged, indicating where the mud fluid was placed and the method or methods used in introducing it into the hole. If cement or other plugs were used, state the character of same and depth placed, from 3232 feet to surface feet for each plug set.

Lane Wells bridging plug had been set at 3238, and hole plugged back to 3238; Hole then filled with sand from 3237 to 3180; four sacks of cement put in hole with bailer to form cement plug from 3180 to 3148; hole filled with mud from 3148 to 190 feet; ten foot rock bridge installed between 190 feet and 180 feet; fifteen sacks of cement poured in hole to form cement plug from 180 feet to 130 feet; hole filled with mud from 130 feet to 35 feet; five foot rock bridge installed between 35 and 30 feet; ten sacks of cement poured in hole, cementing hole to top of pipe and capped.

Plugging complete.

3-9-54

(If additional description is necessary, use BACK of this sheet)

Name of Plugging Contractor Barnes and Sons Pipe Pulling Company, Russell, Kansas.
Address _____

STATE OF Kansas, COUNTY OF Russell, ss.
E. D. Bradstreet (employee of owner) or (owner or operator) of the above-described

well, being first duly sworn on oath, says: That I have knowledge of the facts, statements, and matters herein contained and the log of the above-described well as filed and that the same are true and correct. So help me God.


(Signature) E. D. Bradstreet

126 Grant Russell, Kansas
(Address)

SUBSCRIBED AND SWORN to before me this 8th day of March, 1954

Marquitta Payne
Notary Public.

My commission expires September 17, 1956

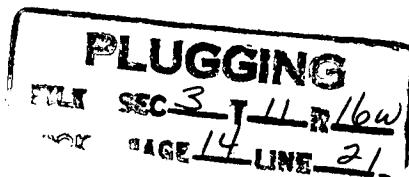

KANSAS WELL LOG BUREAU --- KANSAS GEOLOGICAL SOCIETY
WICHITA, KANSAS

COMPANY Sidey Oil Co.

SEC. 3 T. 11 R. 16W

FARM Ramey

NO. I

LOC. NE $\frac{1}{4}$ NE $\frac{1}{4}$ NW $\frac{1}{4}$

TOTAL DEPTH 3678'

COUNTY Ellis


COMM. 11-5-49

COMP. 11-18-49

SHOT OR TREATED

CONTRACTOR Murfin Drlg. Co.

ISSUED

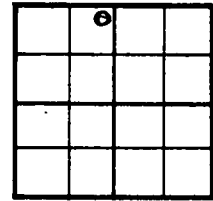

CASING

20	10	
15 $\frac{1}{2}$	8 $\frac{1}{4}$	198' 125 sks. cement
12 $\frac{1}{2}$	6 $\frac{3}{4}$	
13 $\frac{1}{2}$	5 $\frac{1}{2}$	3560' 150 sks. cement

ELEVATION

PRODUCTION

FIGURES INDICATE BOTTOM OF FORMATIONS

245	Shale and shells	3318	Lime and shale
355	Black shale	3515	Lime
400	Sand rock & shale	3602	Lime and shale
530	Shale and shells	3620	Conglomerate
565	Sand	3650	Shale
750	Shale	3661	Smpsn. shale
760	Sand	3678	Arb. Lime
770	Shale and shells		
780	Sand		
800	Shells		
835	Sand and shale		
860	Shale and shells		
885	Sand		
990	Shale		
1120	Red bed		
1180	Red bed and shale		
1205	Red bed and sand		
1235	Red bed and shale		
1275	Anhydrite		
1710	Shale and shells		
1840	Shale and salt		
1890	Shale and lime shells		
1955	Lime and shale		
1990	Lime		
2060	Lime and shale		
2265	Broken lime		
2325	Lime		
2413	Broken lime		
2435	Red rock and lime shells (very soft)		
2440	Lime		
2895	Lime and shale		
2955	Shale and shells		
2975	Broken lime		
3030	Lime and shale		
3215	Lime		
3222	Shale		
3262	K.C. Lime		

STATE OF KANSAS)
) SS:
SEDGWICK COUNTY)

I, Fred Murfin of the Murfin Drilling Company, a partnership, contractor engaged for the drilling of the Ramey No. I well located in the NE $\frac{1}{4}$ NE $\frac{1}{4}$ NW $\frac{1}{4}$ Section 3, Township 11, Range 16 West, Ellis County, Kansas, upon oath state that the above and foregoing is a true and correct copy of the log of said well.

PLUGGING
T11 SEC 3 T 11 R 16W
PAGE 14 LINE 21

Fred Murfin
Fred Murfin

Subscribed and sworn to before me this 25th day of November, 1949

My Commission Expires: 3-5-52

Genevieve Hayes