


STATE OF KANSAS
 STATE CORPORATION COMMISSION

WELL PLUGGING RECORD

Give All Information Completely
 Make Required Affidavit
 Mail or Deliver Report to:
 Conservation Division
 State Corporation Commission
 212 No. Market
 Wichita, Kansas

Rooks County, Sec. 4 Twp. 10 Rge. 17W (E) (W)

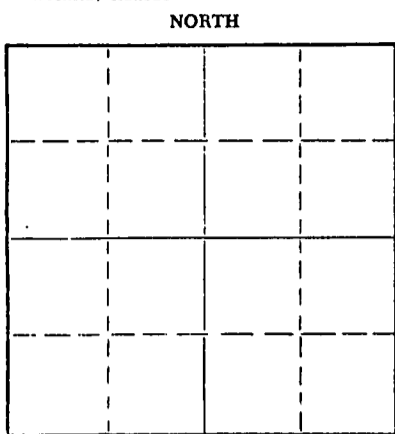

Locate well correctly on above Section Plat

Location as "NE/CNW%SW%" or footage from lines SW NE SE
 Lease Owner Phillips Petroleum Company
 Lease Name Nettie Unit Well No. 10-W02
 Office Address Box 287, Great Bend, Kansas 67530
 Character of Well (completed as Oil, Gas or Dry Hole) Water Input
 Date well completed July 31 1953
 Application for plugging filed 4-20-70 19
 Application for plugging approved 4-21-70 19
 Plugging commenced 4-21-70 19
 Plugging completed 4-21-70 19
 Reason for abandonment of well or producing formation Unable to re-enter for water input
 If a producing well is abandoned, date of last production 19
 Was permission obtained from the Conservation Division or its agents before plugging was commenced? Yes

Name of Conservation Agent who supervised plugging of this well Leo Massey, Box 582, Hays, Kansas
 Producing formation LKC Perf. Depth to top 3400' Bottom 3464' Total Depth of Well 3494' Feet
 Show depth and thickness of all water, oil and gas formations. ^{STP} 3560

OIL, GAS OR WATER RECORDS

CASING RECORD

FORMATION	CONTENT	FROM	TO	SIZE	PUT IN	PULLED OUT
LKC	Oil-Water	3230'	3467'	8-5/8"	190'	None
				5-1/2"	3560'	None

Describe in detail the manner in which the well was plugged, indicating where the mud fluid was placed and the method or methods used in introducing it into the hole. If cement or other plugs were used, state the character of same and depth placed, from _____ feet to _____ feet for each plug set.

Ran 2" open end tubing to 970'. Halliburton pumped 50 sx regular cement w/2% CC down tubing and flushed w/2 barrels water @ 0# press. Pulled 15 jts tubing to 499'. Pumped 10 sx mud gel mixed w/5 sx hulls. Pulled 9 jts tubing to 222'. Pumped 40 sx regular cement and flushed w/2 barrels water. Pulled 7 jts tubing. Let set 3 hrs. Cut 5 1/2" csg off approx 4' below GL. Ran wire line to cement @ 289'. Pumped 35 sx reg cmt in 5 1/2" csg and 50 sx in 8-5/8" csg - both filled to surface. Well P&A'd 4-21-70.

RECEIVED
 STATE CORPORATION COMMISSION
 APR 24 1970
 CONSERVATION DIVISION
 Wichita, Kansas

Halliburton Company was the plugging contractor. Prairie Oil Field Service was the Cable Tool operator.

(If additional description is necessary, use BACK of this sheet)

Name of Plugging Contractor Halliburton Company, Duncan, Oklahoma
 Address Prairie Oil Field Service, Great Bend, Kansas

STATE OF Kansas, COUNTY OF Barton, ss.

A. T. Slagle (employee of owner) or (owner/contractor) of the above-described well, being first duly sworn on oath, says: That I have knowledge of the facts, statements, and matters herein contained and the log of the above-described well as filed and that the same are true and correct. So help me God.

(Signature)

A. T. Slagle

Box 287, Great Bend, Kansas 67530
 (Address)

SUBSCRIBED AND SWORN TO before me this 23rd day of April, 1970

Lura Lee Parks

My commission expires 10-27-73

Notary Public.