

# WELL PLUGGING RECORD

OR

## FORMATION PLUGGING RECORD

Strike out upper line when reporting plugging off formations.

STATE OF KANSAS  
STATE CORPORATION COMMISSION

Give All Information Completely  
Make Required Affidavit  
Mail or Deliver Report to:  
Conservation Division  
State Corporation Commission  
800 Bitting Building  
Wichita, Kansas

Rooks County. Sec. 3 Twp. 10 Rge. (E) 17 (W)

Location as "NE $\frac{1}{4}$ NW $\frac{1}{4}$ SW $\frac{1}{4}$ " or footage from lines. NW  $\frac{1}{4}$  NW  $\frac{1}{4}$  SW  $\frac{1}{4}$

Lease Owner. Isern Drilling Co., et al

Lease Name. Andreson Well No. 1

Office Address. Box 92, Ellinwood, Kansas

Character of Well (completed as Oil, Gas or Dry Hole) Dry Hole

Date well completed. September 18 1950

Application for plugging filed. 9-19-50 19

Application for plugging approved. 9-19-50 19


Plugging commenced. 9-19-50 19

Plugging completed. 9-19-50 19

Reason for abandonment of well or producing formation. Dry hole

If a producing well is abandoned, date of last production. 19

Was permission obtained from the Conservation Division or its agents before plugging was commenced? Yes

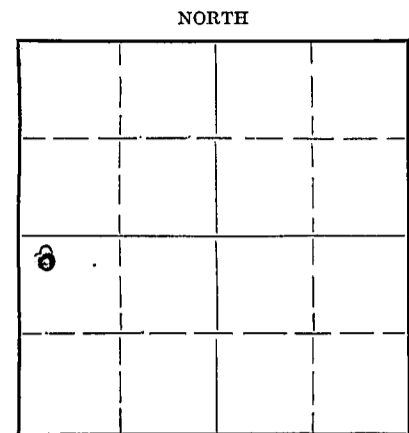

Locate well correctly on above Section Plat

Name of Conservation Agent who supervised plugging of this well. Eldon Petty

Producing formation. Depth to top. Bottom. Total Depth of Well. 3537 Feet

Show depth and thickness of all water, oil and gas formations.

### OIL, GAS OR WATER RECORDS

### CASING RECORD

Formation	Content	From	To	Size	Put In	Pulled Out
Surface pipe		0	184'	8 5/8"	184'	None

Describe in detail the manner in which the well was plugged, indicating where the mud fluid was placed and the method or methods used in introducing it into the hole. If cement or other plugs were used, state the character of same and depth placed, from.....feet to.....feet for each plug set.

Mudded hole with heavy mud to 180'. Bridged hole and dumped 15 sacks cement. Loaded hole with heavy mud to 40'. Bridged at 40' and dumped 10 sacks cement, cement returning to base of cellar.

9-21-50

(If additional description is necessary, use BACK of this sheet)

Correspondence regarding this well should be addressed to. G. W. Keyes Drilling Co.  
Address. Box 92, Ellinwood, Kansas

STATE OF KANSAS, COUNTY OF BARTON, ss.

Edw. H. Isern, Part Owner of the above-described well,

being first duly sworn on oath, says: That I have knowledge of the facts, statements and matters herein contained and the log of the above-described well as filed and that the same are true and correct. So help me God


(Signature) *Edw. H. Isern*

Ellinwood, Kansas (Address)

SUBSCRIBED AND SWORN to before me this 20th day of September, 1950

*George A. Meyer*  
Notary Public

My commission expires February 10, 1951.

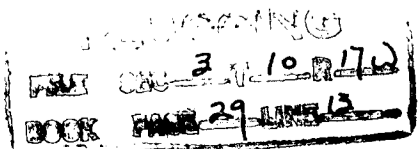

WELL LOG

ISEERN DRILLING COMPANY et al, OWNERS - Andreson #1  
NW 1/4 NW 1/4 SW 1/4 Section 3, Township 10, Range 17W  
Rooks County, Kansas

Elevation: 2080 DF

Figures indicate bottom of formation

0	to	70	clay and post rock
		120	shale and sand
		675	shale and shells
		785	shale and sand
		885	shale and shells
		995	sand
		1335	shale and shells
		1360	anhydrite
		1975	shale and shells
		2410	lime and shale
		2425	sand
		2850	lime and shale
		2966	shale and lime
		3040	lime and shale
		3183	lime
		3187	Heebner
		3223	lime and shale
		3230	Kandas City lime
		3485	lime
		3491	shale and lime
		3496	conglomerate
		3417	simpson shale
		3537	arbuckle lime
		3537	Total Depth D & A

Pipe Records:

8 5/8" set at 184'

Tops: REM

Topoka	2966
Heebner	3183
Lansing	3222
Base Kandas City	3460
Conglomerate	3491
Simpson	3495
Arbuckle	3517

Rotary commenced 9-8-50  
Completed 9-19-50

STATE OF KANSAS )  
COUNTY OF BARTON ) SS

I, Edw. H. Isern, Part Owner, of the above-described well, being first duly sworn on oath, declare: That I have knowledge of the facts, statements and matters herein contained pertaining to the log of the above-described well, as filed, and that the same are true and correct.

*Edw. H. Isern*  
\_\_\_\_\_

Subscribed and Sworn to before me this 27th day of September, 1950.

*George A. Meyer*  
\_\_\_\_\_  
Notary Public

My commission expires Feb. 10, 1951.

**PLUGGING**  
BOOK PAGE 29 LINE 13

NOV 22 1950  
DIVISION  
KANSAS