


Give All Information Completely
Make Required Affidavit
Mail or Deliver Report to:
Conservation Division
State Corporation Commission
211 No. Broadway
Wichita, Kansas

15-063-00003-00-00

WELL PLUGGING RECORD

NORTH

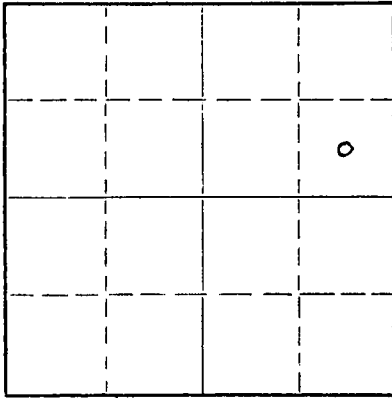

Locate well correctly on above
Section Plat

Gove County, Sec. 1 Twp. 11 S Rge. (E) 27 (W)
Location as "NE/CNW/SW" or footage from lines 1980' fr NL- 660' fr EL
Lease Owner Kimbark Exploration Company
Lease Name Ellithorpe Well No. 1
Office Address 201 University Blvd. - Denver 6, Colorado
Character of Well (completed as Oil, Gas or Dry Hole) Dry Hole
Date well completed 11/19/61 19
Application for plugging filed 11/19/61 19
Application for plugging approved 11/19/61 19
Plugging commenced 11/19/61 19
Plugging completed 11/19/61 19
Reason for abandonment of well or producing formation _____

If a producing well is abandoned, date of last production _____ 19
Was permission obtained from the Conservation Division or its agents before plugging was commenced? Yes

Name of Conservation Agent who supervised plugging of this well Eldon Petty
Producing formation _____ Depth to top _____ Bottom _____ Total Depth of Well 4165 Feet
Show depth and thickness of all water, oil and gas formations.

OIL, GAS OR WATER RECORDS

CASING RECORD

FORMATION	CONTENT	FROM	TO	SIZE	PUT IN	PULLED OUT
Heebner		3857		8 5/8"	231	0
Toronto		3878				
Lansing		3897				

Describe in detail the manner in which the well was plugged, indicating where the mud fluid was placed and the method or methods used in introducing it into the hole. If cement or other plugs were used, state the character of same and depth placed, from _____ feet to _____ feet for each plug set.

4165-550' Heavy Mud
550-475' 20 Sacks Cement
210-150' 20 Sacks Cement
25-0' 10 Sacks Cement

RECEIVED
NOV 29 1961
MAY 21 1962

(If additional description is necessary, use BACK of this sheet)
Name of Plugging Contractor Kimbark Exploration Company
Address 201 University Blvd. - Denver 6, Colorado

STATE OF Colorado, COUNTY OF Denver, ss.
Kimbark Exploration Company (employee of owner) or (owner or operator) of the above-described well, being first duly sworn on oath, says: That I have knowledge of the facts, statements, and matters herein contained and the log of the above-described well as filed and that the same are true and correct. So help me God.

(Signature) [Signature]
201 University Blvd. - Denver, Colo.
(Address)

SUBSCRIBED AND SWORN TO before me this 28th day of November, 19 61
[Signature]
Notary Public.

My commission expires November 15, 1964



15-063-00003-00-00

ELLITHORPE #1 WELL

Location: C SE NE Section 1
T-11-S, R-27-W
Gove County, Kansas

Spudded: 11/10/61
Completed: 11/20/61

Owner: Kimbark Exploration Company
201 University Blvd.
Denver 6, Colorado

Contractor: Kimbark Exploration Co.
201 University Blvd.
Denver 6, Colorado

Surface Casing: 8 5/8" ss casing cemented at 231' K.B. with 175 sacks quick set.

Oil String: None.

LOG


Figures indicate bottom of formation

1,005	Shale
1,985	Sand - Shale
2,530	Shale & Shells
2,755	Shale
2,910	Shale & Lime
3,082	Shale & Lime
3,320	Shale & Lime
3,540	Lime
3,805	Lime
3,965	Lime
4,082	Lime
4,165	Lime
4,165	Rotary Total Depth.

RECEIVED
STATE CORPORATION COMMISSION
11-29-1961
NOV 29 1961
CONSERVATION DIVISION
Wichita, Kansas

The undersigned, W. K. Arbuckle, President of Kimbark Exploration, hereby certifies that the above is a true and correct log of the formations encountered in drilling the Ellithorpe #1 as shown in the daily drilling reports.

KIMBARK EXPLORATION COMPANY



W. K. Arbuckle, President

STATE OF COLORADO)
CITY & COUNTY OF DENVER) ss

Be it remembered that on this 28th day of November A.D. 1961, before me, Marilyn A. Rehm, a Notary Public, personally appeared W. K. Arbuckle, President of Kimbark Exploration Company, a Colorado corporation, who is personally known to me and known to me to be the president of said corporation, and the same person who executed the foregoing instrument, and he duly acknowledged the execution of the same for and on behalf of and as the act and deed of said corporation.

Witness my hand and official seal:
My commission Expires November 15, 1964

