


WELL PLUGGING RECORD

Give All Information Completely
Make Required Affidavit
Mail or Deliver Report to:
Conservation Division
State Corporation Commission
212 No. Market
Wichita, Kansas

Gove County, Sec. 21 Twp. 11 Rge. 28 (E) W (W)

Location as "NE/CNW/SW" or footage from lines NW NW
Lease Owner L. J. Dreiling & Sons, Inc.
Lease Name Riedel Well No. #1
Office Address Route 2, Victoria, Kansas 67671
Character of Well (completed as Oil, Gas or Dry Hole) Dry Hole
Date well completed 3-2 1967
Application for plugging filed 3-2 1967
Application for plugging approved 3-2 1967
Plugging commenced 3-2 1967
Plugging completed 3-2 1967
Reason for abandonment of well or producing formation Dry Hole

NORTH

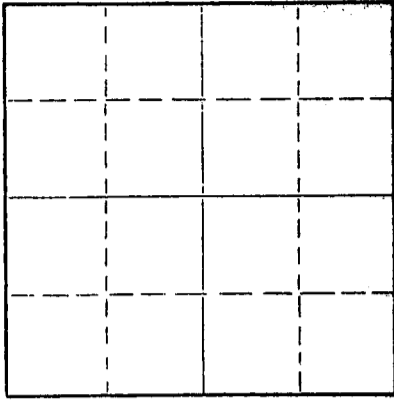

Locate well correctly on above
Section Plat

If a producing well is abandoned, date of last production 19
Was permission obtained from the Conservation Division or its agents before plugging was commenced? Yes

Name of Conservation Agent who supervised plugging of this well Bill Nichols
Producing formation _____ Depth to top _____ Bottom _____ Total Depth of Well _____ Feet
Show depth and thickness of all water, oil and gas formations.

OIL, GAS OR WATER RECORDS

CASING RECORD

| FORMATION | CONTENT | FROM | TO | SIZE | PUT IN | PULLED OUT |
|--------------|---------|------|----|--------|--------|------------|
| Surface Pipe | | | | 8 5/8" | 183' | |
| | | | | | | |
| | | | | | | |
| | | | | | | |
| | | | | | | |

Describe in detail the manner in which the well was plugged, indicating where the mud fluid was placed and the method or methods used in introducing it into the hole. If cement or other plugs were used, state the character of same and depth placed, from _____ feet to _____ feet for each plug set.

Filled hole with rotary mud to a depth of 600' where 1st. plug was set using 20 sacks cement. Filling hole with rotary mud to a depth of 85' where 2nd. plug was set using 25 sacks cement and cementing to bottom of cellar.

MAR 11 1967

(If additional description is necessary, use BACK of this sheet)

Name of Plugging Contractor L. J. Dreiling & Sons, Inc.
Address Route 2, Victoria, Kansas

STATE OF KANSAS, COUNTY OF ELLIS, ss.
I, Leo F. Dreiling (employee of owner) or (owner or operator) of the above-described well, being first duly sworn on oath, says: That I have knowledge of the facts, statements, and matters herein contained and the log of the above-described well as filed and that the same are true and correct. So help me God.

(Signature) Leo F. Dreiling
Leo F. Dreiling, Route 2, Victoria, Kansas
(Address)

SUBSCRIBED AND SWORN TO before me this 2nd. day of March, 19 67.

My commission expires September 19, 1970

Joseph A. Hess
JOSEPH A. HESS Notary Public.

L. J. DREILING and SONS, Inc.

VICTORIA, KANSAS

WELL LOG

| | | | | |
|--------------------|--|-------------------|----------------|----------------|
| Company | L. J. Dreiling & Sons, Inc. Route 2, Victoria, Kansas 67671 | Sec. 21 | Twp. 11 | Rng. 28 |
| Farm | Riedel No. #1 | Location | NW NW | |
| Total Depth | 4500' | County | Gove | |
| Comm. | 2-23-67 | Comp. | 3-2-67 | |
| Contractor | L. J. Dreiling & Sons, Inc. | Elevation: | 2764' | K.B. |
| | | | 2762' | D. F. |
| | | | | G. R. |

Casing Record

183' - 8 5/8"

Cement Record

175 sacks cement

Production: D & A

Figures Indicate Bottom of Formations

| | | |
|-------|-------|----------------|
| 0' | 40' | Surface Soil |
| 40' | 183' | Sand & Clay |
| 183' | 1230' | Shale & Shells |
| 1230' | 1460' | Sand |
| 1460' | 1565' | Shale |
| 1565' | 1630' | Sand |
| 1630' | 1666' | Shale |
| 1666' | 1676' | Lime |
| 1676' | 1920' | Shale & Gyp |
| 1920' | 2150' | Redbed & Shale |
| 2150' | 2285' | Redbed & Shale |
| 2285' | 2320' | Anhy. |
| 2320' | 2685' | Shale & Shells |
| 2685' | 2920' | Shale & Lime |
| 2920' | 2989' | Shale |
| 2989' | 3012' | Sharp Lime |
| 3012' | 3110' | Shale & Lime |
| 3110' | 3203' | Shale & Lime |
| 3203' | 3304' | Lime & Shale |
| 3304' | 3555' | Lime & Shale |
| 3555' | 3710' | Lime & Shale |
| 3710' | 3857' | Lime & Shale |
| 3857' | 3945' | Lime & Shale |
| 3945' | 4055' | Lime & Shale |
| 4055' | 4121' | Lime |
| 4121' | 4230' | Lime |
| 4230' | 4295' | Lime & Shale |
| 4295' | 4390' | Lime |
| 4390' | 4450' | Lime |
| 4450' | 4469' | Sherty Lime |
| 4469' | 4500' | Lime |
| 4500' | T.D. | |

3-7-1967

STATE OF KANSAS)
)ss
COUNTY OF ELLIS)

I, Leo F. Dreiling of the L. J. Dreiling & Sons, Inc., upon oath states that the above and foregoing is a true and correct copy from the Daily Drilling report from your Riedel #1.

Leo F. Dreiling

LEO F. DREILING

Subscribed and sworn to before me this 2nd. day of March 1967.

Joseph A. Hess

JOSEPH A. HESS NOTARY PUBLIC

My commission expires: September 19, 1970