


WELL PLUGGING RECORD

Give All Information Completely
Make Required Affidavit
Mail or Deliver Report to:
Conservation Division
State Corporation Commission
211 No. Broadway
Wichita, Kansas

Gove County. Sec. 22 Twp. 11S Rge. (E) 28 (W)

Location as "NE/CNW/SW" or footage from lines C-SW-SE
Lease Owner Sunray Mid-Continent Oil Company
Lease Name J. Heier Well No. 1
Office Address Box # 788, Great Bend, Kansas
Character of Well (completed as Oil, Gas or Dry Hole) Dry Hole
Date well completed April 24 19 59
Application for plugging filed April 24 19 59
Application for plugging approved April 27 19 59
Plugging commenced April 24 19 59
Plugging completed April 24 19 59
Reason for abandonment of well or producing formation _____

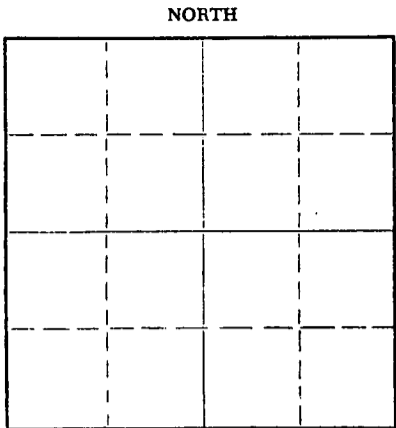

Locate well correctly on above
Section Plat

If a producing well is abandoned, date of last production _____ 19____
Was permission obtained from the Conservation Division or its agents before plugging was commenced? Yes

Name of Conservation Agent who supervised plugging of this well A. D. Fabricius
Producing formation _____ Depth to top _____ Bottom _____ Total Depth of Well 4590 Feet
Show depth and thickness of all water, oil and gas formations.

OIL, GAS OR WATER RECORDS

CASING RECORD

FORMATION	CONTENT	FROM	TO	SIZE	PUT IN	PULLED OUT
				8 5/8"	219'	None

Describe in detail the manner in which the well was plugged, indicating where the mud fluid was placed and the method or methods used in introducing it into the hole. If cement or other plugs were used, state the character of same and depth placed, from _____ feet to _____ feet for each plug set.

Filled hole w/ drlg mud to 600', set wood plug & 20 sacks cement. Filled hole w/ mud to 200', set wood plug & 15 sacks cement. Filled hole w/ mud to 40', wood plug & 1/3 sacks hulls & 10 sacks cement. Plugging completed.

Log attached.

RECEIVED
STATE CORPORATION COMMISSION
4-30-1959
APR 30 1959

CONSERVATION DIVISION
Wichita, Kansas

(If additional description is necessary, use BACK of this sheet)
Name of Plugging Contractor Halliburton Oil Well Cementing Co.
Address _____

STATE OF KANSAS, COUNTY OF BARTON, ss.
N. E. Montgomery (employee of owner) or (~~owner of property~~) of the above-described well, being first duly sworn on oath, says: That I have knowledge of the facts, statements, and matters herein contained and the log of the above-described well as filed and that the same are true and correct. So help me God.

(Signature) N. E. Montgomery
Box # 788, Great Bend, Kansas
(Address)

SUBSCRIBED AND SWORN TO before me this 29 day of April, 19 59

H. H. H. H.

My commission expires Dec. 24, 1960

Notary Public.

PLUGGING
FILE SEC. 22 T. 11 R. 28W
BOOK PAGE 33 LINE 27

15-063-00015-00-00

Sunray Mid-Continent Oil Company
Tulsa, Oklahoma

Tulsa, Oklahoma
April 27, 1959

CONTRACTOR: Stickle Drilling Company
Drilling Commenced: April 13, 1959
Drilling Completed: April 24, 1959

Heier #1 SW SE Section
22-11S-28W, Gove County,
Kansas.

DRILLERS LOG

Depth Figures Indicate Base of Formation:

Surface	0
Shale	110
Sand	160
Shale & Shells	220
Shale	1030
Sand	1275
Sandy Shale	1475
Sand	1640
Shale, Sand & Shells	2150
Shale & Sand	2280
Anhydrite	2325
Shale & Shells	2390
Red Rock, Shale & Shells	2665
Shale & Lime	2915
Lime & Shale	3120
Shale & Lime	3260
Lime & Shale	3894
Lime	4124
Lime & Shale	4357
Sand	4371
Shale & Lime	4376
Lime & Shale	4439
Lime & Chert	4480
Chert & Lime	4543
Lime	4590 TD

I, Fred E. Stickle hereby certify the above to be a true and complete Drillers Log of Sunray Mid-Continent Oil Company's Heier #1 SW SE Section 22-11S-28W, Gove County, Kansas.

Lillian T. Bonham
Notary Public

February 13, 1960
My Commission Expires

