


STATE OF KANSAS
STATE CORPORATION COMMISSION
200 Colorado Derby Bldg.
Wichita, Kansas 67202

WELL PLUGGING RECORD

Give All Information Completely
Make Required Affidavit

COUNTY Gove SEC. 27 TWP. 11S RGE. 28W E/W
Location as in quarters or footage from lines:
NE SE

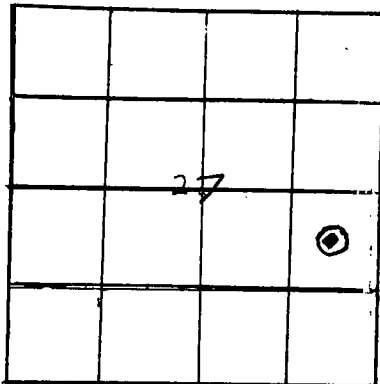

Lease Owner Cinco Exploration ETAL
Lease Name Ziegler Well No. 1
Office Address P. O. Box 3723, Victoria, Texas 77903
Character of Well (Completed as Oil, Gas or Dry Hole): Dry Hole
Date Well Completed 6/29/83
Application for plugging filed 6/29/83
Plugging commenced 6/29/83
Plugging completed 6/29/83
Reason for abandonment of well or producing formation Dry Hole

Locate Well
correctly on above
Section Platt.

Was permission obtained from the Conservation Division or it's
Agent's before plugging was commenced? yes

Name of Conservation Agent who supervised plugging of this well Gilbert Scheck
Producing formation _____ Depth to top _____ bottom _____ T.D. 4550
Show depth and thickness of all water, oil and gas formations.

OIL, GAS OR WATER RECORDS

Casing Record

Formation	Content	From	To	Size	Put in	Pulled Out


Describe in detail the manner in which the well was plugged, indicating where the mud
fluid was placed and the method or methods used in introducing it into the hold. If cement
or other plugs were used, state the character of same and depth placed, from _____ feet
to _____ feet for each plug set.

Plugged: w/ 20 sks @ 2250'
100 sks @ 1300'
40 sks @ 375'
10 sks @ 40' w/ hulls plug
10 sks Rat hole
10 sks mousehole
Cement: 50-50 Pozmicx, 6% Gel 3% CC

(If additional description is necessary, use BACK of this sheet)

Name of Plugging Contractor Sun Cementing

STATE OF Kansas COUNTY OF Sedgwick, ss.
Jerome D. Marcus (employee of owner) or (owner or operator) of the
above-described well, being first duly sworn on oath, says: That I have knowledge of the
facts, statements, and matters herein contained and the log of the above-described well as
filed and that the same are true and correct. So help me God.

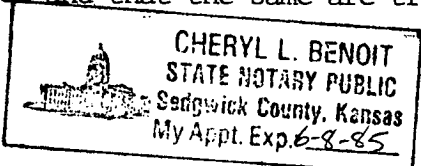

(Signature) [Signature]
401 E. Douglas, Suite 402, Wichita, KS
(Address) 67202

SUBSCRIBED AND SWORN TO before me this 8th day of July, 1983

Cheryl L. Benoit
Notary Public.

My Commission expires: June 8, 1985 STATE CORPORATION COMMISSION

7-19-1983
JUL 19 1983

CONSERVATION DIVISION
Wichita, Kansas