

CARD MUST BE TYPED

State of Kansas
NOTICE OF INTENTION TO DRILL
(see rules on reverse side)

CARD MUST BE SIGNED

Starting Date: February 3, 1985
month day year

API Number 15- 063-20,879-00-00
 East

OPERATOR: License # 5565

NW.. NW. SW. Sec 32. Twp 11. S, Rge 29. West

Name National Cooperative Refinery Assoc. (location)

Address Box 6 2310..... Ft North from Southeast Corner of Section

City/State/Zip Great Bend, Kansas 67530 4950..... Ft West from Southeast Corner of Section

Contact Person I. J. Gotsche (Note: Locate well on Section Plat on reverse side)

Phone 316 793-7824

Nearest lease or unit boundary line 330 feet.

CONTRACTOR: License # 5302

County Gove

Name Red Tiger Drilling Co.

Lease Name Camp Lord Well# 1

City/State Wichita, Ks.

Domestic well within 330 feet : yes no

Well Drilled For: Well Class: Type Equipment:

Municipal well within one mile : yes no

Oil Swd Infield Mud Rotary

Gas Inj Pool Ext. Air Rotary

OWWO Expl Wildcat Cable

Depth to Bottom of fresh water 120 feet

Lowest usable water formation Dakota

Depth to Bottom of usable water 1400 feet

Surface pipe by Alternate : 1 2

Surface pipe to be set 300 feet

Conductor pipe if any required feet

Ground surface elevation feet MSL

This Authorization Expires 7-29-85

Approved By 1-28-85 

If OWWO: old well info as follows:

Operator

Well Name

Comp Date Old Total Depth

Projected Total Depth 4600 feet

Projected Formation at TD Mississippi

Expected Producing Formations Lansing, Mississippi

I certify that we will comply with K.S.A. 55-101, et seq., plus eventually plugging holes to K.C.C. specifications.

Date 1/24/85 Signature of Operator or Agent

I. J. Gotsche

Title District Superintendent


Form C-1 4/84

MHC/KOHE 1-28-85

Must be filed with the K.C.C. five (5) days prior to commencing well
 This card void if drilling not started within six (6) months of date received by K.C.C.

Important procedures to follow :

A Regular Section of Land
1 Mile = 5,280 Ft.

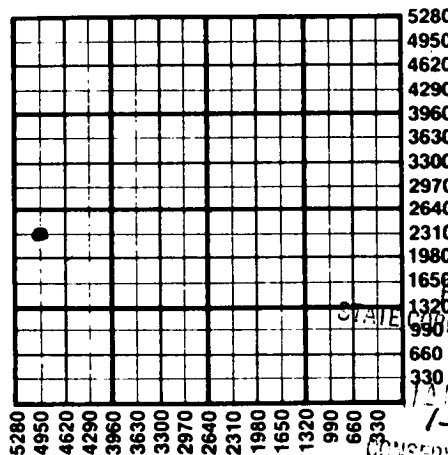

1. Notify District office before setting surface casing.
2. Set surface casing by circulating cement to the top.
3. File completion forms ACO-1 with K.C.C. within 90 days of well completion, following instructions on ACO-1, side 1, and including copies of wireline logs.
4. Notify District office 48 hours prior to old well workover or re-entry.
5. Prior to plugging, prepare a plugging plan, then obtain agreement from the appropriate district office for an approved plugging plan.
6. Submit plugging report (CP-4) to K.C.C. after plugging is completed.
7. Obtain an approved injection docket number before disposing of salt water.
8. Notify K.C.C. within 10 days when injection commences or terminates.
9. If an alternate 2 completion, cement in the production pipe from below any usable water to surface within 120 days of spud date.

RECEIVED
 STATE CORPORATION COMMISSION
 JAN 28 1985
 1-28-1985
 CONSERVATION DIVISION
 Wichita, Kansas

State Corporation Commission of Kansas
Conservation Division
200 Colorado Derby Building
Wichita, Kansas 67202
(316) 263-3238