

S

15-063-21019-00-00

SIDE ONE

STATE CORPORATION COMMISSION OF KANSAS
OIL & GAS CONSERVATION DIVISION

WELL COMPLETION OR RECOMPLETION FORM
ACO-1 WELL HISTORY

DESCRIPTION OF WELL AND LEASE

Operator: License # 5140
Name Frontier Oil Company
Address 125 N. Market, Ste 1720
Wichita
City/State/Zip Ks. 67202

Purchaser N/A

Operator Contact Person Jean Angle
Phone 316-263-1201

Contractor: License # 5302
Name Red Tiger Drilling Co.

Wellsite Geologist Steven D. Angle
Phone 913-483-5348

Designate Type of Completion

- New Well
- Re-Entry
- Workover
- Oil
- Gas
- Dry
- SWD
- Inj
- Other (Core, Water Supply etc.)
- Temp Abd
- Delayed Comp.

If OWWO: old well info as follows:

Operator
Well Name
Comp. Date Old Total Depth

WELL HISTORY

Drilling Method:

- Mud Rotary
- Air Rotary
- Cable

2-27-86 3-13-86 3-13-86
Spud Date Date Reached TD Completion Date
4600' N/A
Total Depth PBTB

Amount of Surface Pipe Set and Cemented at 343 feet
Multiple Stage Cementing Collar Used? Yes No
If yes, show depth set...feet
If alternate 2 completion, cement circulated from...feet depth to...w/...SX cmt

API NO. 15-15-063-21-019-00-00

County COVA

C. NE SW Sec 15 Twp 11S Rge 30 East West

1980' Ft North from Southeast Corner of Section
3300' Ft West from Southeast Corner of Section
(Note: Locate well in section plat below)


Lease Name Harper "B" Well # 1

Field Name Verhoeff So. Ext.

Producing Formation N/A

Elevation: Ground KB 2902'

Section Plat

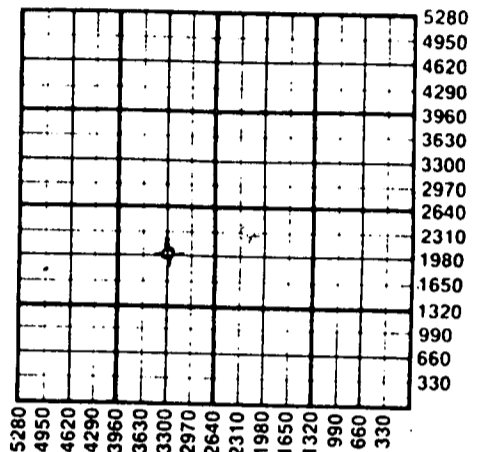

WATER SUPPLY INFORMATION

Disposition of Produced Water: N/A Disposal
Docket # Repressuring

Questions on this portion of the ACO-1 call:

Water Resources Board (913) 296-3717

Source of Water: City of Grinnell, Ks.

Division of Water Resources Permit #

- Groundwater.....Ft North from Southeast Corner (Well)Ft West from Southeast Corner
Sec Twp Rge East West
- Surface Water.....Ft North from Southeast Corner (Stream, pond etc).....Ft West from Southeast Corner
Sec Twp Rge East West
- Other (explain)...City of Grinnell.....
(purchased from city, R.W.D. #)

INSTRUCTIONS: This form shall be completed in duplicate and filed with the Kansas Corporation Commission, 200 Colorado Derby Building, Wichita, Kansas 67202, within 90 days after completion or recompletion of any well. Rule 82-3-130 and 82-3-107 apply. Information on side two of this form will be held confidential for a period of 12 months if requested in writing and submitted with the form. See rule 82-3-107 for confidentiality in excess of 12 months. One copy of all wireline logs and drillers time log shall be attached with this form. Submit CP-4 form with all plugged wells. Submit CP-111 form with all temporarily abandoned wells.

All requirements of the statutes, rules and regulations promulgated to regulate the oil and gas industry have been fully complied with and the statements herein are complete and correct to the best of my knowledge.

Signature *Jean Angle*
Agent
Date 5-9-86

Notary Public: *Delia J. Henley*
Date Commission Expires: 9/22/86

K.C.C. OFFICE USE ONLY

- Letter of Confidentiality Attached
- Wireline Log Received
- Drillers Timelog Received

Distribution

- KCC
- KGS
- SWD/Rep
- Plug
- NGPA
- Other (Specify)

RECEIVED
MAY 12 1986
5-12-1986
CONSERVATION DIVISION
Wichita, Kansas

Form ACO-1 (7-84)

Sec. 15 Twp. 11S Rge. 30W