

CARD MUST BE TYPED

State of Kansas
NOTICE OF INTENTION TO DRILL

COLLECTION
CARD MUST BE SIGNED
12-1984

(see rules on reverse side)

Starting Date: 12 2 1984
month day year

API Number 15- 195-21,643 - 00-00

OPERATOR: License # 6113
Name Landmark Oil Exploration, Inc.
Address 105 S. Broadway, Suite 1040
City/State/Zip Wichita, Kansas 67202
Contact Person Jeffrey R. Wood
Phone (316) 265-8181

**E/2. NW SE. NW... Sec. 13. Twp. 11. S, Rge. 25
(location) East West

CONTRACTOR: License # 5420
Name White & Ellis Drilling, Inc.
City/State Wichita, Kansas

* 3650 Ft North from Southeast Corner of Section
* 3490 Ft West from Southeast Corner of Section
(Note: Locate well on Section Plat on reverse side)

Well Drilled For: Well Class: Type Equipment:
 Oil Swd Infield Mud Rotary
 Gas Inj Pool Ext. Air Rotary
 OWWO Expl Wildcat Cable

Nearest lease or unit boundary line 850 feet.
County Trego
Lease Name Connor Well# 1-13
Domestic well within 330 feet: yes no
Municipal well within one mile: yes no

If OWWO: old well info as follows:

Operator
Well Name
Comp Date Old Total Depth
Projected Total Depth 4050 feet
Projected Formation at TD BKC
Expected Producing Formations Kansas City

Depth to Bottom of fresh water 100 feet
Lowest usable water formation Dakota
Depth to Bottom of usable water ~~100~~ 1100 feet
Surface pipe by Alternate: 1 2
Surface pipe to be set 225 feet
Conductor pipe if any required None feet
Ground surface elevation 2452 feet MSL
This Authorization Expires 5-28-85
Approved By *11-28-84*

I certify that we will comply with K.S.A. 55-101, et seq., plus eventually plugging hole to K.C.C. specifications. *was: 3640 FSL 3580 FEL*

Date 12-17-84 Signature of Operator or Agent Jeffrey R. Wood Title President


Form C-1 4/84

**was: Approx. NW SE NW

Must be filed with the K.C.C. five (5) days prior to commencing well
 This card void if drilling not started within six (6) months of date received by K.C.C.

Important procedures to follow:

A Regular Section of Land
1 Mile = 5,280 Ft.

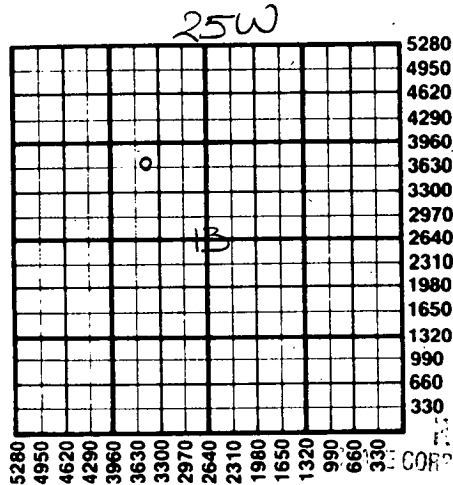

1. Notify District office before setting surface casing.
2. Set surface casing by circulating cement to the top.
3. File completion forms ACO-1 with K.C.C. within 90 days of well completion, following instructions on ACO-1, side 1, and including copies of wireline logs.
4. Notify District office 48 hours prior to old well workover or re-entry.
5. Prior to plugging, prepare a plugging plan, then obtain agreement from the appropriate district office for an approved plugging plan.
6. Submit plugging report (CP-4) to K.C.C. after plugging is completed.
7. Obtain an approved injection docket number before disposing of salt water.
8. Notify K.C.C. within 10 days when injection commences or terminates.
9. If an alternate 2 completion, cement in the production pipe from below any usable water to surface within 120 days of spud date.

RECEIVED

CORPORATION COMMISSION

State Corporation Commission of Kansas
Conservation Division

200 Colorado Derby Building
Wichita, Kansas 67202
(316) 263-3238

DEC 18 1984
 12-18-1984
 CONSERVATION DIVISION
 Wichita, Kansas