

CARD MUST BE TYPED

State of Kansas  
**NOTICE OF INTENTION TO DRILL**

CARD MUST BE SIGNED

(see rules on reverse side)

Starting Date: July 15, 1985  
month day year

API Number 15- 195-21,749-00-00

OPERATOR: License # 5068

NE NE SW  East  
(location) Sec 20 Twp 11 S, Rge 25  West

Name Thomas E. Black

Address 527 Union Center Bldg.

City/State/Zip Wichita, Kansas 67202

Contact Person Thomas E. Black

Phone 316-264-9342

CONTRACTOR: License # 5110

Name B. & B. Drilling, Inc.

City/State Wichita, Kansas 67202

Well Drilled For: Well Class: Type Equipment:

- Oil  Swd  Infield  Mud Rotary
- Gas  Inj  Pool Ext.  Air Rotary
- OWWO  Expl  Wildcat  Cable

If OWWO: old well info as follows:

Operator .....

Well Name .....

Comp Date ..... Old Total Depth .....

Projected Total Depth 4150 feet

Projected Formation at TD Base Kansas City

Expected Producing Formations Lansing Kansas City

2310 Ft North from Southeast Corner of Section  
2970 Ft West from Southeast Corner of Section  
(Note: Locate well on Section Plat on reverse side)

Nearest lease or unit boundary line 330 feet.

County Trego

Lease Name DINKEL Well# 1

Domestic well within 330 feet:  yes  no

Municipal well within one mile:  yes  no

Depth to Bottom of fresh water ..... feet

Lowest usable water formation ..... feet

Depth to Bottom of usable water Data 200 feet

Surface pipe by Alternate: 1  2

Surface pipe to be set 250 feet

Conductor pipe if any required ..... feet

Ground surface elevation ..... feet MSL

This Authorization Expires 1-11-86

Approved By 7-11-85

I certify that we will comply with K.S.A. 55-101, et seq., plus eventually plugging hole to K.C.C. specifications.

Date 7/11/85 Signature of Operator or Agent


Thomas E. Black Title Owner

*The production string will be immediately cemented*

RECEIVED  
 STATE CORPORATION COMMISSION  
 07-11-1985  
 JUL 11 1985

Must be filed with the K.C.C. five (5) days prior to commencing well  
 This card void if drilling not started within six (6) months of date received by K.C.C.

CONSERVATION DIVISION  
 A Regular Section of Land  
 Wichita, Kansas  
 1 Mile = 5,280 Ft.

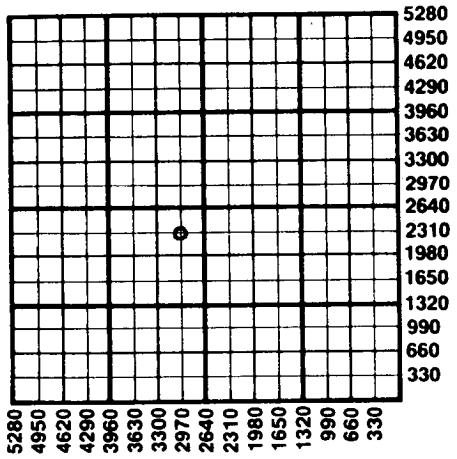

**Important procedures to follow:**

1. Notify District office before setting surface casing.
2. Set surface casing by circulating cement to the top.
3. File completion forms ACO-1 with K.C.C. within 90 days of well completion, following instructions on ACO-1, side 1, and including copies of wireline logs.
4. Notify District office 48 hours prior to old well workover or re-entry.
5. Prior to plugging, prepare a plugging plan, then obtain agreement from the appropriate district office for an approved plugging plan.
6. Submit plugging report (CP-4) to K.C.C. after plugging is completed.
7. Obtain an approved injection docket number before disposing of salt water.
8. Notify K.C.C. within 10 days when injection commences or terminates.
9. If an alternate 2 completion, cement in the production pipe from below any usable water to surface within 120 days of spud date.

State Corporation Commission of Kansas  
 Conservation Division  
 200 Colorado Derby Building  
 Wichita, Kansas 67202  
 (316) 263-3238