


STATE OF KANSAS  
STATE CORPORATION COMMISSION

WELL PLUGGING RECORD

Give All Information Completely  
Make Required Affidavit  
Mail or Deliver Report to  
Conservation Division  
State Corporation Comm.  
245 North Water  
Wichita, KS 67202

Trego County, Sec. 15 Twp. 11S Rge. 25 E/W  
Location as "NE/CNW $\frac{1}{4}$ SW $\frac{1}{4}$ " or footage from lines  
150' SSW NE NW

Lease Owner Mack Oil Co.  
Lease Name Palkowsky Well No. #1  
Office Address 908 Union Center Bldg., Wichita, Kansas 67202  
Character of Well (Completed as Oil, Gas or Dry Hole)

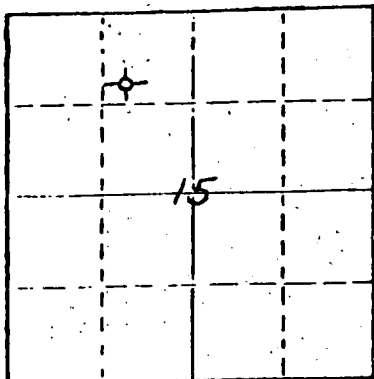

Locate well correctly on above  
Section Plot

Dry Hole  
Date Well completed 6-9-78 19  
Application for plugging filed 6-9-78 19  
Application for plugging approved 6-9-78 19  
Plugging commenced 6-9-78 19  
Plugging completed 6-9-78 19

Reason for abandonment of well or producing formation  
Commercial quantities of oil not found  
If a producing well is abandoned, date of last production 19

Was permission obtained from the Conservation Division or  
its agents before plugging was commenced? Yes

Name of Conservation Agent who supervised plugging of this well Gilbert Balthazor, Palco, Ks.  
Producing formation Depth to top Bottom Total Depth of Well 4070'  
Show depth and thickness of all water, oil and gas formations.

OIL, GAS OR WATER RECORDS

CASING RECORD

FORMATION	CONTENT	FROM	TO	SIZE	PUT IN	PULLED OUT
				8 5/8"	207'	None

Describe in detail the manner in which the well was plugged, indicating where the mud fluid was placed and the method or methods used in introducing it into the hold. If cement or other plugs were used, state the character of same and depth placed, from feet to feet for each plug set.

Plug @ 900' w/70 sx.  
Plug @ 185' w/20 sx.  
Plug @ 40' w/10 sx.

RECEIVED  
STATE CORPORATION COMMISSION

JUN 20 1978  
06-20-1978  
CONSERVATION DIVISION  
Wichita, Kansas

(If additional description is necessary, use BACK of this sheet)

Name of Plugging Contractor Rains & Williamson Oil Co., Inc.


STATE OF Kansas COUNTY OF Sedgwick, ss.  
Wilson Rains, President of Rains & Williamson Oil Co., Inc. (employee of owner) or (owner or operator) of the above-described well, being first duly sworn on oath, says: That I have knowledge of the facts, statements, and matters herein contained and the log of the above-described well as filed and that the same are true and correct. So help me God.

(Signature) Wilson Rains  
435 Page Court, 220 W. Douglas, Wichita, Ks. 67202  
(Address)

Subscribed AND SWORN TO before me this 13 day of June, 1978

My commission expires 10-4-79

Juanita M. Green  
Juanita M. Green Notary Public.

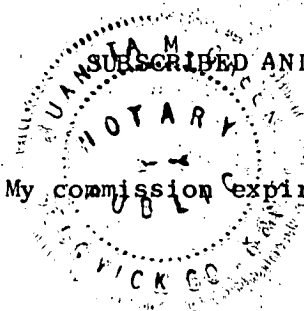

15-195-20476-00-00

DRILLER'S LOG

COMPANY: Mack Oil Co.

SEC. 15 T. 11S R. 25W

150' S  
LOC. SW NE NW

WELL NAME: Palkowsky #1

COUNTY: Trego

RIG NO. #4

TOTAL DEPTH 4070'

ELEVATION 2473' GL

COMMENCED: 6-1-78

COMPLETED: 6-9-78

CONTRACTOR: Rains & Williamson Oil Co., Inc.

CASING RECORD:

SURFACE: 8 5/8" @ 207' w/175 sx. 60/40 poz., 2% gel, 3% cc.

PRODUCTION: D&A

LOG

(Figures Indicate Bottom of Formations)

Sand & Shale	215
Shale & Sand	1071
Sand & Shale	1205
Shale	1970
Redbed & Shale	2071
Redbed, Shale & Sand	2695
Lime & Shale	2823
Shale	3780
Lime	4070
<u>ROTARY TOTAL DEPTH</u>	<u>4070</u>

RECEIVED  
STATE CORPORATION COMMISSION

JUN 20 1978  
06-20-1978  
CONSERVATION DIVISION  
Wichita, Kansas

STATE OF Kansas )

COUNTY OF Sedgwick )

SS:

I, Wilson Rains, President of Rains & Williamson Oil Co., Inc.

upon oath state that the above and foregoing is a true and correct copy of the log of the

Palkowsky #1 well.

*Wilson Rains*

Wilson Rains

Subscribed and sworn to before me this 13 day of June, 1978.

My Appointment Expires:

10-4-79

*Juanita M. Green*  
Juanita M. Green

