


15-167-06145-00-00
WELL PLUGGING RECORD

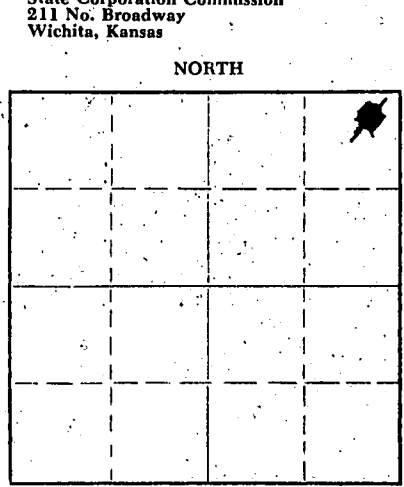

Locate well correctly on above Section Plat

Russell County. Sec. 17 Twp. 11 Rge. 15 (E) (W)
 Location as "NE/CNW/SW" or footage from lines NE NE NE
 Lease Owner R. P. Nixon
 Lease Name American Investment Well No. 1
 Office Address 754 East Wichita Ave., Russell, Kansas
 Character of Well (completed as Oil, Gas or Dry Hole) Oil well
 Date well completed January 18 19 57
 Application for plugging filed May 1 19 57
 Application for plugging approved May 3 19 57
 Plugging commenced May 29 19 57
 Plugging completed May 29 19 57
 Reason for abandonment of well or producing formation oil depleted
 If a producing well is abandoned, date of last production April 26 19 57
 Was permission obtained from the Conservation Division or its agents before plugging was commenced? yes

Name of Conservation Agent who supervised plugging of this well Milton Galyardt
 Producing formation _____ Depth to top _____ Bottom _____ Total Depth of Well 3405' Feet
 Show depth and thickness of all water, oil and gas formations.

OIL, GAS OR WATER RECORDS				CASING RECORD		
FORMATION	CONTENT	FROM	TO	SIZE	PUT IN	PULLED OUT
				8 5/8"	1012'	Cemented
				4 1/2"	3405	2490

Describe in detail the manner in which the well was plugged, indicating where the mud fluid was placed and the method or methods used in introducing it into the hole. If cement or other plugs were used, state the character of same and depth placed, from _____ feet to _____ feet for each plug set.

Filled hole with sand from 3278' to 3000', dump 4 sacks cement; pull pipe out, filled hole with chunk mud up to 300', rock bridge, 20 sacks of cement, mud on up to 35', rock bridge and 10 sacks cement.

(If additional description is necessary, use BACK of this sheet)
 Name of Plugging Contractor Arnett Casing Pulling Company
 Address 172 West 3rd, Hoisington, Kansas

STATE OF Kansas COUNTY OF Russell ss.
R. P. Nixon (employee of owner) or (owner or operator) of the above-described well, being first duly sworn on oath, says: That I have knowledge of the facts, statements, and matters herein contained and the log of the above-described well as filed and that the same are true and correct. So help me God.

(Signature) [Signature]


(Address) _____, 19 57

SUBSCRIBED AND SWORN to before me this 13th day of June, 19 57
 My commission expires 12-9-59

[Signature] Notary Public.
 STATE CORPORATION COMMISSION

PLUGGING
 FILE SEC. 17 T. 11 R. 15W
 BOOK PAGE 10 LINE 33

JUN 14 1957
 06-14-1957
 CONSERVATION DIVISION
 Wichita, Kansas

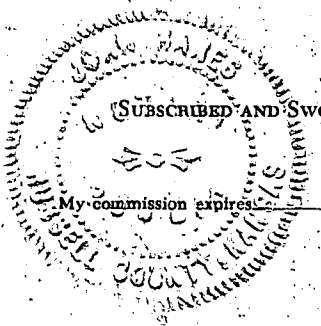

15-167-06145-00-00

OPERATOR: R. P. Nixon
Russell, Kansas

CONTRACTOR: Wentworth Drilling Co.
Russell, Kansas

LEASE: American Investment #1
NE/4 Sec. 17-11S-15W
Russell County, Kansas

Commenced: 12-24-56
Completed: 1-18-57

FORMATION	DEPTH
Top soil, Sand	90
Shale-Shells-Sand	430
Shale-Shells	550
Sand-Shale	640
Shale-Shells, Red Bed	820
Shale-Red Bed	1002
Anhydrite	1012
Shale-Shells-Red Bed	1210
Shale-Shells-Red Bed	1700
Shale-Shells	1855
Shale-Lime	1897
Lime-Shale	1935
Lime-Shale	2015
Lime-Shale	1210
Shale-Lime	2275
Shale-Lime	2355
Shale-Lime	2550
Shale-Shells	2745
Shale-Shells	2810
Shells-Lime	2875
Lime-Shale	2915
Lime-Shale	2960
Lime	3390
TOTAL DEPTH	3405

I hereby certify that the above is true and correct to the best of my knowledge.

R. P. Nixon

R. P. Nixon

STATE OF KANSAS)
County of Russell) SS

Subscribed and sworn to before me on this 17th day of June, 1957.

Joan Hanes
Joan Hanes-Notary Public

My commission expires 12-9-59

RECEIVED
STATE CORPORATION COMMISSION

JUN 19 1957
06-19-1957
CONSERVATION DIVISION
Wichita, Kansas

PLUGGING
FILE SEC 17 T 11 R 15
BOOK PAGE 10 LINE 33