

15-195-20493-00-00


STATE OF KANSAS
STATE CORPORATION COMMISSION

WELL PLUGGING RECORD

Give All Information Completely
Make Required Affidavit
Mail or Deliver Report to
Conservation Division
State Corporation Comm.
245 North Water
Wichita, KS 67202

Trego County, Sec. 14 Twp. 11S Rge. 25
Location as "NE/CNW $\frac{1}{2}$ /SW $\frac{1}{2}$ " or footage from lines
NE NW NW

Lease Owner Mack Oil Company
Lease Name Mattie Well No. #1
Office Address 908 Union Center, Wichita, Kansas 67202
Character of Well (Completed as Oil, Gas or Dry Hole)
Dry Hole

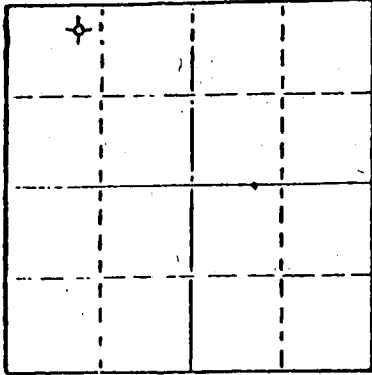

Locate well correctly on above
Section Plat

Date Well completed 9-22-78 19
Application for plugging filed 9-21-78 19
Application for plugging approved 9-21-78 19
Plugging commenced 9-21-78 19
Plugging completed 9-22-78 19
Reason for abandonment of well or producing formation

Commercial quantities of oil not found
If a producing well is abandoned, date of last production 19

Was permission obtained from the Conservation Division or
its agents before plugging was commenced? Yes

Name of Conservation Agent who supervised plugging of this well Leo Massey, Hays, Kansas
Producing formation Depth to top Bottom Total Depth of Well 4080'
Show depth and thickness of all water, oil and gas formations.

OIL, GAS OR WATER RECORDS

CASING RECORD

FORMATION	CONTENT	FROM	TO	SIZE	PUT IN	PULLED OUT
				8 5/8"	218'	None

Describe in detail the manner in which the well was plugged, indicating where the mud fluid was placed and the method or methods used in introducing it into the hold. If cement or other plugs were used, state the character of same and depth placed, from feet to feet for each plug set.

RECEIVED
STATE CORPORATION COMMISSION

Plug @ 900' w/70 sx.
Plug @ 215' w/20 sx.
Plug @ 40' w/10 sx.

SEP 29 1978
09-29-1978
CONSERVATION DIVISION
Wichita, Kansas

(If additional description is necessary, use BACK of this sheet)

Name of Plugging Contractor Rains & Williamson Oil CO., Inc.

STATE OF Kansas COUNTY OF Sedgwick, ss.

Wilson Rains, President of Rains & Williamson Oil Co, Inc (employee of owner) or (owner or operator) of the above-described well, being first duly sworn on oath, says: That I have knowledge of the facts, statements, and matters herein contained and the log of the above-described well as filed and that the same are true and correct. So help me God.

(Signature)

Wilson Rains

435 Page Court, 220 W. Douglas, Wichita, Kansas
(Address)

SUBSCRIBED AND SWORN TO before me this 27 day of September, 1978

Juanita M. Green
Juanita M. Green Notary Public.

My commission expires 10-4-79



DRILLER'S LOG

15-195-20493-00-00

COMPANY: Mack Oil Company

SEC. 14 T. 11S R. 25W

WELL NAME: Mattie #1

LOC. NE NW NW

COUNTY: Trego

RIG NO. #4

TOTAL DEPTH 4080'

ELEVATION

COMMENCED: 9-11-78

COMPLETED: 9-22-78

CONTRACTOR: Rains & Williamson Oil Co., Inc.

CASING RECORD:

SURFACE: 8 5/8" @ 218' w/175 sx. Class A, 2% gel, 3% cc.

PRODUCTION: D&A

LOG

(Figures Indicate Bottom of Formations)

Shale	670
Shale, Sand & Shale	1515
Shale & Sand	1825
Redbed & Shale	2355
Shale	3250
Shale & Lime	3435
Lime & Shale	3560
Shale & Lime	3665
Lime & Shale	3770
Shale	3850
Shale & Lime	3860
Lime	4080
<u>ROTARY TOTAL DEPTH</u>	<u>4080</u>

RECEIVED
STATE CORPORATION COMMISSION

SEP 29 1978
09-29-78
CONSERVATION DIVISION
Wichita, Kansas

STATE OF Kansas)

COUNTY OF Sedgwick)

SS:

I, Wilson Rains, President of Rains & Williamson Oil Co., Inc.

upon oath state that the above and foregoing is a true and correct copy of the log of the

Mattie #1 well.

Wilson Rains

Wilson Rains

Subscribed and sworn to before me this 27 day of September, 1978.

My Commission Expires:

10-4-79

Juanita M. Green
Juanita M. Green

