

15-195-20020-00-00

STATE OF KANSAS  
STATE CORPORATION COMMISSION

Form CP-4

WELL PLUGGING RECORD

Give All Information Completely  
Make Required Affidavit  
Mail or Deliver Report to:  
Conservation Division  
State Corporation Commission  
212 No. Market  
Wichita, Kansas

Trego County, Sec. 17 Twp. 11S Rge. 25W (W)

Location as "NE/CNW/SW" or footage from lines SE SE SE

Lease Owner D. R. Lauck Oil Company, Inc.

Lease Name Ziegler Well No. 1

Office Address 301 S. Broadway, Wichita, Kansas

Character of Well (completed as Oil, Gas or Dry Hole) Dry Hole

Date well completed June 9, 1967

Application for plugging filed June 9, 1967

Application for plugging approved June 9, 1967


Plugging commenced June 9, 1967

Plugging completed June 9, 1967

Reason for abandonment of well or producing formation Dry Hole

If a producing well is abandoned, date of last production \_\_\_\_\_ 19\_\_\_\_

Was permission obtained from the Conservation Division or its agents before plugging was commenced? Yes

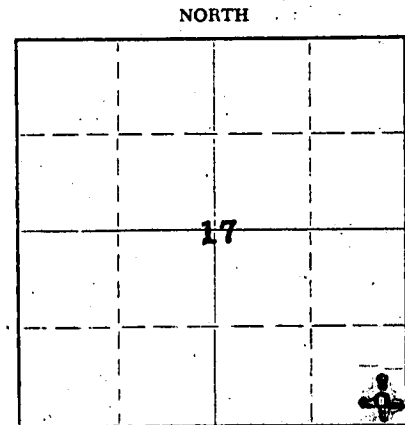

Locate well correctly on above Section Plat

Name of Conservation Agent who supervised plugging of this well Bill Nichols

Producing formation \_\_\_\_\_ Depth to top \_\_\_\_\_ Bottom \_\_\_\_\_ Total Depth of Well 4030 Feet

Show depth and thickness of all water, oil and gas formations.

OIL, GAS OR WATER RECORDS

CASING RECORD

FORMATION	CONTENT	FROM	TO	SIZE	PUT IN	PULLED OUT
		0'	218'	8-5/8"	218'	None

RECEIVED  
STATE CORPORATION COMMISSION  
JUN 21 1967  
06-21-1967  
CONSERVATION DIVISION  
WICHITA, KANSAS

Describe in detail the manner in which the well was plugged, indicating where the mud fluid was placed and the method or methods used in introducing it into the hole. If cement or other plugs were used, state the character of same and depth placed from \_\_\_\_\_ feet to \_\_\_\_\_ feet for each plug set.

4030'-480' Mud  
 480'-476' Plug  
 476'-436' Cement, 15 sacks  
 436'-240' Mud  
 240'-236' Plug  
 236'-196' Cement, 25 sacks  
 196'-40' Mud  
 40'-36' Plug  
 36'-6' Cement, 10 sacks (Bottom of cellar)

(If additional description is necessary, use BACK of this sheet)

Name of Plugging Contractor Lauck Drilling Company, Incorporated  
Address 301 S. Broadway, Wichita, Kansas


STATE OF KANSAS, COUNTY OF SEDGWICK, ss.  
John H. Knightley (employee of owner) or (owner or operator) of the above-described well, being first duly sworn on oath, says: That I have knowledge of the facts, statements, and matters herein contained and the log of the above-described well as filed and that the same are true and correct. So help me God.

(Signature) John H. Knightley  
301 S. Broadway, Wichita, Kansas  
(Address)

SUBSCRIBED AND SWORN TO before me this 19th day of June, 1967

Stella J. Lippe  
Notary Public.

My commission expires March 12, 1971

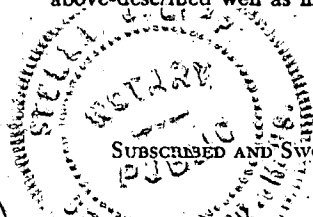

15-195-20020-00-00

D. R. Lauck Oil Company, Inc.

Ziegler #1

SE SE SE Sec. 17-11S-25W  
Trego County, Kansas

Commenced: June 1, 1967  
Completed: June 9, 1967

Casing Record: 218' 8-5/8" Cemented with 165 sacks Cement,  
4 sacks Calcium Chloride.

Elevation: GL 2441; DF 2444; KB 2446.

Drillers Log

Tops

		Samples	Electra
Surface Clay	20	2020+426	2016+430
Shale Shells	45	3721-1275	3718-1272
Shale	840	3747-1301	3742-1296
Sand	900	3761-1315	3756-1310
Shale	960	Base Kansas City	4008-1562
Sand	1020	Total Depth	4030-1584 4025-1579
Shale Shells & Sand	1490		
Shale, Red Bed & Sand	1720		
Shale & Red Bed	2020		
Anhydrite	2050	DST #1 (S) 3835-60, Open 30 minutes,	
Shale & Shells	2495	weak blow 6 minutes, flushed	
Shale & Lime	2580	tool. Recovered 15' slightly	
Lime & Shale	2610	oil specked mud. FSIP 1272#,	
Lime	2765	30 minutes.	
Lime & Shale	2889	DST #2 (S) 3914-31, straddle test.	
Shale & Lime	3620	Open 1 hour, strong blow.	
Lime & Shale	3711	Recovered 2880' water. Bottom	
Lime	4030 RTD	packer failed.	
		DST #3 (S) 3912-29, straddle test.	
		Open 20 minutes, weak blow 1	
		minute, flushed tool. Recovered	
		3' mud. FSIP 28#, 30 minutes.	
		FP 19#-19#.	

D&A

RECEIVED  
STATE CORPORATION COMMISSION  
JUN 21 1967  
06-21-1967  
CONSERVATION DIVISION  
Wichita, Kansas