

15-063-21184-00-00

TYPE OR PRINT

NOTICE: Fill out completely
and return to Cons. Div.
office within 30 days.

LEASE OPERATOR Pickrell Drilling Co., Inc.

ADDRESS 110 N. Market, Suite 205, Wichita KS 67202

PHONE# (316) 262-8427 OPERATORS LICENSE NO. 5123

Character of Well Oil

(Oil, Gas, D&A, SWD, Input, Water Supply Well)

The plugging proposal was approved on 1-28-92 (date)

by Carl Goodrow (KCC District Agent's Name).

Is ACO-1 filed? Yes If not, Is well log attached? _____

Producing Formation LKC Depth to Top 4147 Bottom 4402 T.D. 4600

Show depth and thickness of all water, oil and gas formations.

OIL, GAS OR WATER RECORDS

CASING RECORD

Formation	Content	From	To	Size	Put In	Pulled out
		0	358	8 5/8	358	None
		0	4509	4 1/2	4509	None

Handwritten notes and stamps:
5-20-1992
5-20-1992
5-20-1992

Describe in detail the manner in which the well was plugged, indicating where the mud fluid was placed and the method or methods used in introducing it into the hole. If cement or other plugs were used, state the character of same and depth placed, from feet to feet each set. Allied Cementing Co. pressure checked 8 5/8" x 4 1/2" annulus to 500# o.k. Pumped down 4 1/2" 350 SX 65/35 POZ, mixed 10% gel & 500# cottonseed hulls in first of cement. Filled casing 0'-4402' and pressured to 1500#. Left S.I. with 300#.

(If additional description is necessary, use BACK of this form.)

Name of Plugging Contractor Allied Cementing Co. License No. N/A

Address P.O. Box 31, Russell KS 67665


NAME OF PARTY RESPONSIBLE FOR PLUGGING FEES: Pickrell Drilling Co., Inc.

STATE OF Kansas COUNTY OF Sedgwick, ss.

Jack Gurley (Employee of Operator) or (Operator) of above-described well, being first duly sworn on oath, says: That I have knowledge of the facts, statements, and matters herein contained and the log of the above-described well as filed that the same are true and correct, so help me God.

(Signature) Jack Gurley

(Address) 110 N. Market, Ste. 205 Wichita KS

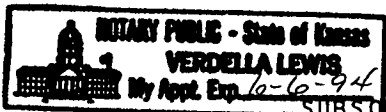

SUBSCRIBED AND SWORN TO before me this 19th day of March, 19 92


Verdella Lewis
Notary Public

My Commission Expires: 6-6-94

BAKER SERVICE TOOLS - TALLY PAD

New Completion Workover 15-063-21184-00-00

Oil Company _____ Well No. A-2 Field _____ Lease Lockwood Tr
Company Man _____ Date Drilled 3/1988 County Gove State KS.

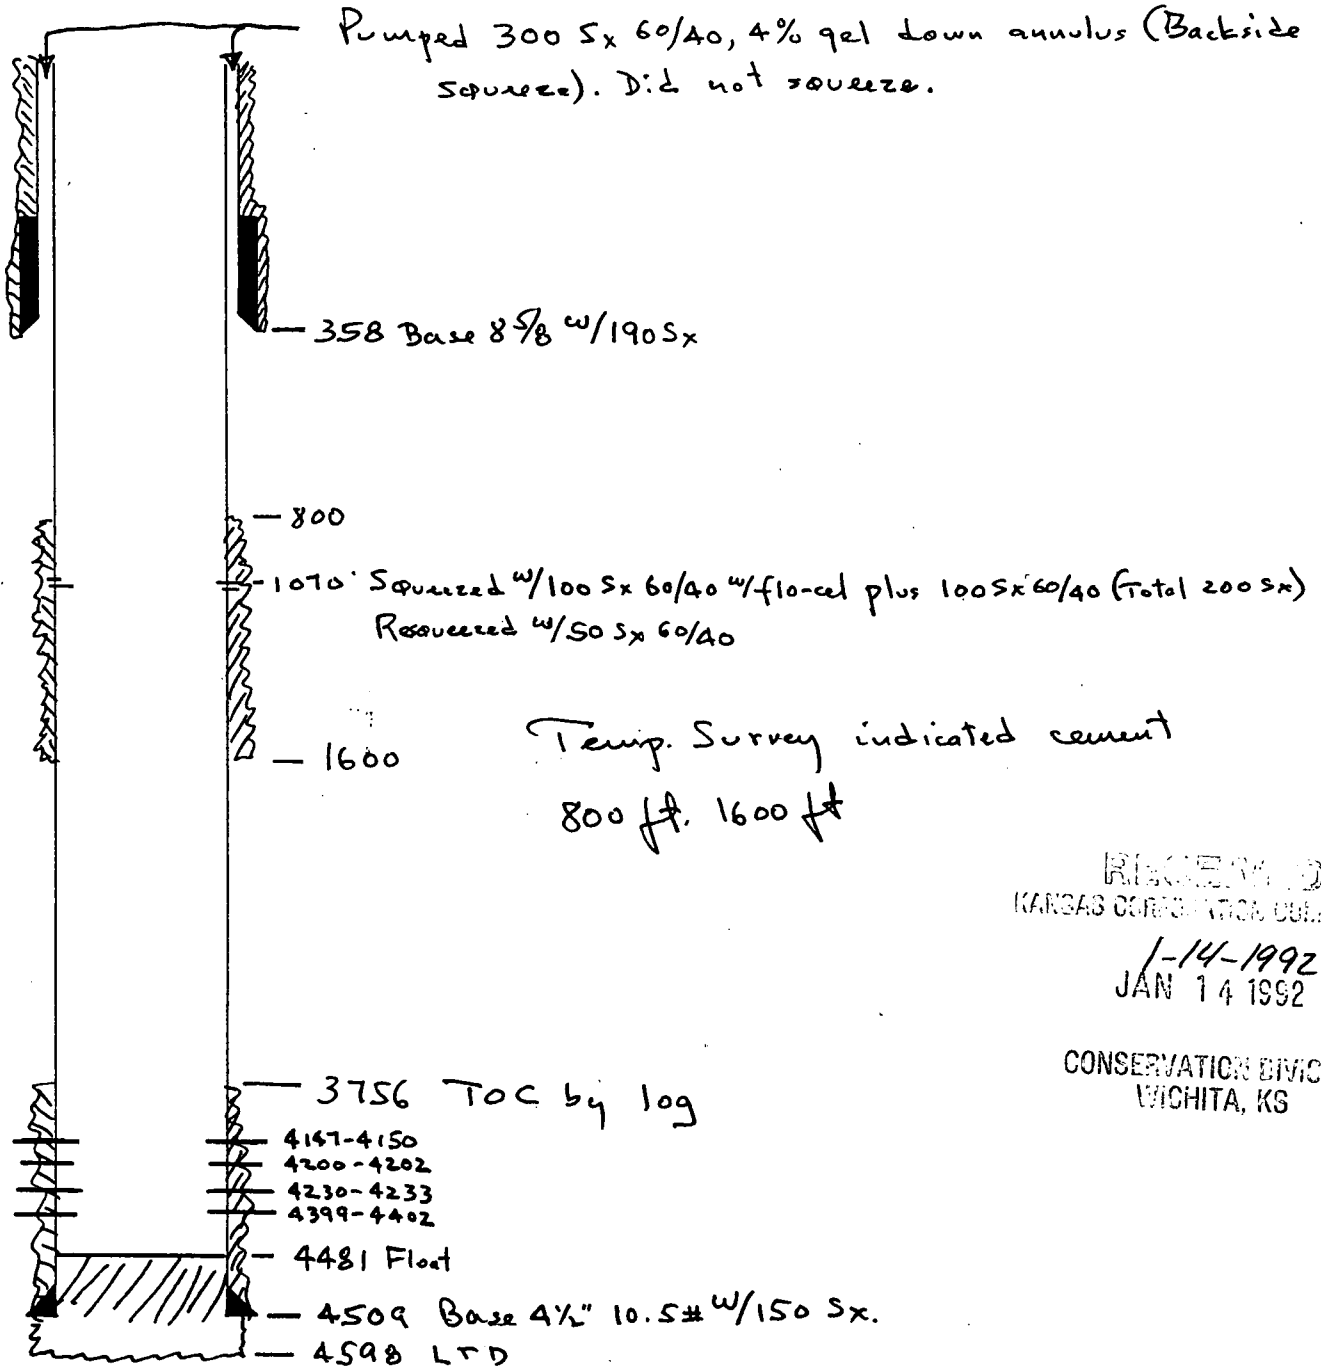

RECEIVED
KANSAS CORPORATION COMMISSION

1-14-1992
JAN 14 1992

CONSERVATION DIVISION
WICHITA, KS

REMARKS: _____

