

STATE OF KANSAS
STATE CORPORATION COMMISSION


Form CP-4

Give All Information Completely
Make Required Affidavit
Mail or Deliver Report to:
Conservation Division
State Corporation Commission
211 No. Broadway
Wichita, Kansas

WELL PLUGGING RECORD

Rooks County, Sec. 5 Twp. 10S Rge. 17W (E) (W)

Location as "NE/CNW/SW" or footage from lines 240' N. of SE NW SW
Lease Owner Davis Bros.
Lease Name Dechant "D" Well No. 1
Office Address 510 McFarlin Bldg., Tulsa, Oklahoma 74103
Character of Well (completed as Oil, Gas or Dry Hole) Dry Hole
Date well completed October 29 19.65
Application for plugging filed October 29 19.65
Application for plugging approved October 29 19.65
Plugging commenced October 29 19.65
Plugging completed October 29 19.65
Reason for abandonment of well or producing formation No production

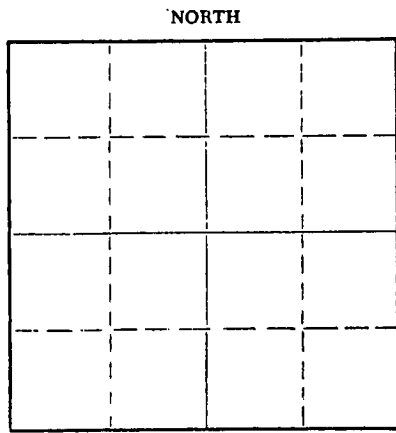

If a producing well is abandoned, date of last production 19
Was permission obtained from the Conservation Division or its agents before plugging was commenced? Yes

Name of Conservation Agent who supervised plugging of this well Eldon Petty, Box 326, Hays, Kansas
Producing formation _____ Depth to top _____ Bottom _____ Total Depth of Well _____ Feet
Show depth and thickness of all water, oil and gas formations.

OIL, GAS OR WATER RECORDS CASING RECORD

FORMATION	CONTENT	FROM	TO	SIZE	PUT IN	PULLED OUT
				8 5/8"	149'	None

Describe in detail the manner in which the well was plugged, indicating where the mud fluid was placed and the method or methods used in introducing it into the hole. If cement or other plugs were used, state the character of same and depth placed, from _____ feet to _____ feet for each plug set.

Filled hole with heavy mud to 145', set plug, cemented with 40 sacks
Filled hole with heavy mud to 40', set plug, cemented with 10 sacks to bottom of cellar

RECEIVED
STATE CORPORATION COMMISSION
11-10-65
NOV 10 1965
CONSERVATION DIVISION
Wichita, Kansas

(If additional description is necessary, use BACK of this sheet)

Name of Plugging Contractor Transit Corporation
Address 1516 Liberty Bank Bldg., Oklahoma City, Oklahoma 73102

STATE OF Oklahoma, COUNTY OF Oklahoma, ss.
L. J. Kruse (employee of owner) or (operator) of the above-described well, being first duly sworn on oath, says: That I have knowledge of the facts, statements, and matters herein contained and the log of the above-described well as filed and that the same are true and correct. So help me God.

(Signature) L. J. Kruse
(Address) _____

SUBSCRIBED AND SWORN TO before me this 8th day of November, 1965
Paul E. Hartman
Notary Public.

My commission expires January 3, 1966

DRILLER'S WELL LOG

Davis Bros.

Dechant "D" # 1 located
240' N. of SE NW SW
Section 5-10S-17W
Rooks County, KansasCommenced: October 21, 1965
Completed: October 29, 1965
Elevation: 2058 R.B.Casing: 8 5/8" @ 152'
Cemented: w/100 sacks

<u>Formation</u>	<u>From</u>	<u>To</u>
Surface soil	0	152
Shale	152	760
Sand and shale	760	830
Shale and shells	830	875
Sand	875	1000
Shale	1000	1115
Red Bed shale	1115	1341
Anhydrite	1341	1377
Shale	1377	1880
Shale and lime streaks	1880	1990
Shale and lime	1990	2170
Lime and shale	2170	2205
Lime w/shale	2205	2325
Lime and shale	2325	2674
Shale w/lime	2674	2820
Shale and lime	2820	2965
Shale w/lime	2965	2989
Topeka lime	2989	3070
Lime	3070	3195
Lime and shale	3195	3265
Lime	3265	3477 T.D.

RECEIVED
STATE CORPORATION COMMISSION
NOV 10 1965
CONSERVATION DIVISION
Wichita, Kansas

I hereby certify the foregoing to be a true and correct driller's log of the formations encountered in the above well.

Subscribed and sworn to before me

TRANSIT CORPORATION

this 8th day of November, 1965

By L. J. Kruse

My commission expires January 3, 1966

Paul E. Gilman
Notary Public