

CARD MUST BE TYPED

State of Kansas
NOTICE OF INTENTION TO DRILL
(see rules on reverse side)

CARD MUST BE SIGNED

Starting Date: 9/24/85
month day year

API Number IS- 109-20,400-00-00

OPERATOR: License # 6879
Name Solar Petroleum, Inc.
Address 1099 18th St., Suite 2900
City/State/Zip Denver, CO 80202
Contact Person Dave Cushman
Phone 303/292-5850

NE SW NE Sec 1 Twp 11 S, Rge 32 East West
(location)

3360 Ft North from Southeast Corner of Section
1720 Ft West from Southeast Corner of Section
(Note: Locate well on Section Plat on reverse side)

CONTRACTOR: License #
Name Not selected at present
City/State

Nearest lease or unit boundary line 1650 feet.
County Logan
Lease Name Valeda Steinle Well# 1

Well Drilled For: Well Class: Type Equipment:
 Oil Swd Infield Mud Rotary
 Gas Inj Pool Ext. Air Rotary
 OWWO Expl Wildcat Cable

Domestic well within 330 feet: yes no
Municipal well within one mile: yes no

If OWWO: old well info as follows:
Operator
Well Name
Comp Date Old Total Depth
Projected Total Depth 4800 feet
Projected Formation at TD Mississippian
Expected Producing Formations Lansing-Kansas City & Pawnee

250
Depth to Bottom of fresh water feet
Lowest usable water formation Dakota
Depth to Bottom of usable water 1700 feet
Surface pipe by Alternate: 1 2
Surface pipe to be set 300 feet
Conductor pipe if any required feet
Ground surface elevation 3032 feet MSI.
This Authorization Expires 3-25-86

I certify that we will comply with K.S.A. 55-101, et seq., plus eventually plugging hole to K.C.C. specifications.


Date 9/17/85 Signature of Operator or Agent *Edta Daniel* Title

Approved By *E. Feit/Kate*
Executive Assistant

RECEIVED
 STATE CORPORATION COMMISSION
 SEP 25 1985
 9-25-1985
 CONSERVATION DIVISION
 Wichita, Kansas

Must be filed with the K.C.C. five (5) days prior to commencing well
 This card void if drilling not started within six (6) months of date received by K.C.C.

A Regular Section of Land
 1 Mile = 5,280 Ft.

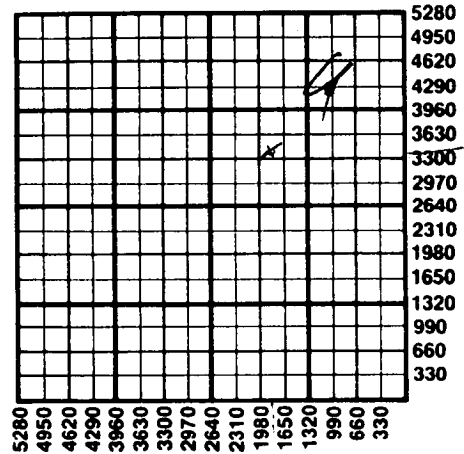

Important procedures to follow :

1. Notify District office before setting surface casing.
2. Set surface casing by circulating cement to the top.
3. File completion forms ACO-1 with K.C.C. within 90 days of well completion, following instructions on ACO-1, side 1, and including copies of wireline logs.
4. Notify District office 48 hours prior to old well workover or re-entry.
5. Prior to plugging, prepare a plugging plan, then obtain agreement from the appropriate district office for an approved plugging plan.
6. Submit plugging report (CP-4) to K.C.C. after plugging is completed.
7. Obtain an approved injection docket number before disposing of salt water.
8. Notify K.C.C. within 10 days when injection commences or terminates.
9. If an alternate 2 completion, cement in the production pipe from below any usable water to surface within 120 days of spud date.

State Corporation Commission of Kansas
 Conservation Division
 200 Colorado Derby Building
 Wichita, Kansas 67202
 (316) 263-3238