

NOTICE OF INTENTION TO DRILL

(see rules on reverse side)

Starting Date February 7, 1986 month day year

API Number 15- 109-20,412-00-00

OPERATOR: License # 5063 Energy Exploration, Inc. 1002 South Broadway Wichita, Ks. 67211 Brad Lehl (316) 267-7336

SE NW NW Sec. 1 Twp. 11 S, Rg. 32 East West 4290 Ft. from South Line of Section 4290 Ft. from East Line of Section

(Note: Locate well on Section Plat on reverse side)

CONTRACTOR: License # 5422 Abercrombie Drilling, Inc. Wichita, Ks.

Nearest lease or unit boundary line 990 feet County Logan

Lease Name Stall Well # 1 Ground surface elevation not available feet MSL

Well Drilled For: Well Class: Type Equipment: Oil SWD Infield Mud Rotary Gas Inj Pool Ext. Air Rotary OWWO Wildcat Cable

Domestic well within 330 feet: yes no Municipal well within one mile: yes no Surface pipe by Alternate: 1 2 Depth to bottom of fresh water 250' 1700' Depth to bottom of usable water Surface pipe planned to be set 300' Projected Total Depth 4700 feet Formation Mississippian

If OWWO: old well info as follows:

Operator Well Name Comp Date Old Total Depth

I certify that well will comply with K.S.A. 55-101, et seq., plus eventually plugging hole to KCC specifications.

cementing will be done immediately upon setting production casing. Date 1-10-86 Signature of Operator or Agent Title District Geologist

For KCC Use:


Conductor Pipe Required feet; Minimum Surface Pipe Required 300 feet per mt. This Authorization Expires 7-14-86 Approved By 1-14-86

Must be filed with the K.C.C. five (5) days prior to commencing well
This card void if drilling not started within six (6) months of date received by K.C.C.

Important procedures to follow:

1. Notify District office before setting surface casing.
2. Set surface casing by circulating cement to the top.
3. File completion forms ACO-1 with K.C.C. within 90 days of well completion, following instructions on ACO-1, side 1, and including copies of wireline logs.
4. Notify District office 48 hours prior to old well workover or re-entry.
5. Prior to filing Intent, prepare a proposed plugging plan in case well is D & A, then obtain approval of plan when calling district office prior to setting surface pipe.
6. Submit plugging report (CP-4) to K.C.C. after plugging is completed.
7. Obtain an approved injection docket number before disposing of salt water.
8. Notify K.C.C. within 10 days when injection commences or terminates.
9. If an alternate 2 completion, cement in the production pipe from below any usable water to surface within 120 days of spud date.

A Regular Section of Land
1 Mile = 5,280 Ft.

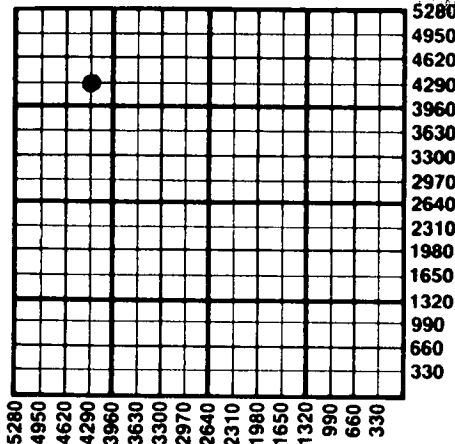

STATE CORPORATION COMMISSION

JAN 14 1980
1-14-1980

State Corporation Commission of Kansas
Conservation Division
200 Colorado Derby Building
Wichita, Kansas 67202
(316) 263-3238