

CARD MUST BE TYPED

State of Kansas

CARD MUST BE SIGNED

NOTICE OF INTENTION TO DRILL The prod. csg. will be cmted (see rules on reverse side) from below useable water to surf. immediately upon compl. of well.

Starting Date November 29 1985 month day year 2:00

API Number 15- 109-20,408-00-00

OPERATOR: License # 5181 Name SLAWSON, DONALD C. Address 200 Douglas Bldg. City/State/Zip Wichita, Kansas 67202 Contact Person Bill Horigan Phone 316.263-3201

APP SE. NE. NE Sec. 6.. Twp. 11.. S, Rg. 32. X West 4360' Ft. from South Line of Section 330' Ft. from East Line of Section

(Note: Locate well on Section Plat on reverse side)

CONTRACTOR: License # 5657 Name Slawson Drilling Co. City/State Wichita, Kansas

Nearest lease or unit boundary line 330' feet County Logan

Lease Name Bradshaw 'G' Well # L Ground surface elevation 309.1 GR feet MSL

Well Drilled For: Well Class: Type Equipment: X Oil SWD Infield X Mud Rotary Gas Inj X Pool Ext Air Rotary OWWO Expl Wildcat Cable

Domestic well within 330 feet: yes no Municipal well within one mile: yes no Surface pipe by Alternate: 1 2 X

If OWWO: old well info as follows:

Depth to bottom of fresh water 230' Depth to bottom of usable water 1750' Surface pipe planned to be set 280' Projected Total Depth 4725' feet Formation Mississippi

Operator Well Name Comp Date Old Total Depth

I certify that well will comply with K.S.A. 55-101, et seq., plus eventually plugging hole to KCC specifications.

cementing will be done immediately upon setting production casing.

Date 11/27/85 Signature of Operator or Agent

Robert B. Jenkins

Kansas Western District Geologist

For KCC Use:

Conductor Pipe Required feet; Minimum Surface Pipe Required feet per Alg 1 2

This Authorization Expires 5-27-86 Approved By 11-27-85

RCA/KWA

Must be filed with the K.C.C. five (5) days prior to commencing well
 This card void if drilling not started within six (6) months of date received by K.C.C.

Important procedures to follow:

RECEIVED
 STATE CORPORATION COMMISSION

1. Notify District office before setting surface casing.

NOV 27 1985
 11-27-1985

2. Set surface casing by circulating cement to the top.

CONSERVATION DIVISION
 Wichita, Kansas

3. File completion forms ACO-1 with K.C.C. within 90 days of well completion, following instructions on ACO-1, side 1, and including copies of wireline logs.

A Regular Section of Land
1 Mile = 5,280 Ft.

4. Notify District office 48 hours prior to old well workover or re-entry.


5. Prior to filing Intent, prepare a proposed plugging plan in case well is D & A, then obtain approval of plan when calling district office prior to setting surface pipe.

6. Submit plugging report (CP-4) to K.C.C. after plugging is completed.

7. Obtain an approved injection docket number before disposing of salt water.

8. Notify K.C.C. within 10 days when injection commences or terminates.

9. If an alternate 2 completion, cement in the production pipe from below any usable water to surface within 120 days of spud date.

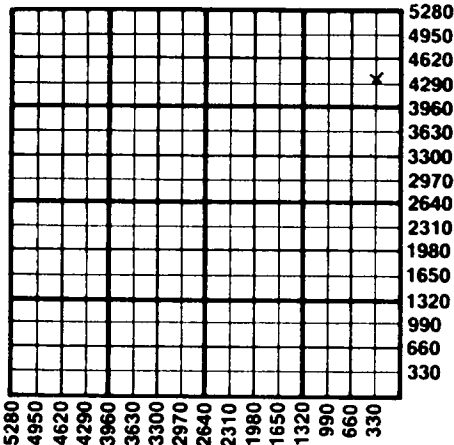

State Corporation Commission of Kansas
 Conservation Division
 200 Colorado Derby Building
 Wichita, Kansas 67202
 (316) 263-3238