

STATE CORPORATION COMMISSION OF KANSAS
OIL & GAS CONSERVATION DIVISION
WELL COMPLETION OR RECOMPLETION FORM
ACO-1 WELL HISTORY
DESCRIPTION OF WELL AND LEASE

Operator: License # 8541 & 9152
Name Petex & Marexco
Address Route 2, Box 553
City/State/Zip Rogersville, MO 65742

Purchaser.....

Operator Contact Person Larry Childers
Phone 417-8876289

Contractor: License # 9087
Name R & C Drilling, Inc.

Wellsite Geologist Steve Marden
Phone 303-237-5716

Designate Type of Completion
 New Well Re-Entry Workover
 Oil SWD Temp Abd
 Gas Inj Delayed Comp.
 Dry Other (Core, Water Supply etc.)

If OMWO: old well info as follows:
Operator
Well Name
Comp. Date Old Total Depth.....

WELL HISTORY

Drilling Method:
 Mud Rotary Air Rotary Cable

..4-6-86... ..4-16-86... ..4-16-86...
Spud Date Date Reached TD Completion Date
...4700'.....
Total Depth PBTB

Amount of Surface Pipe Set and Cemented at 281 feet
Multiple Stage Cementing Collar Used? Yes No
If yes, show depth set.....feet
If alternate 2 completion, cement circulated
from.....feet depth to.....w/.....SX cmt
Cement Company Name
Invoice #

API NO. 15-109-20,419-00-00
County Logan
NW NE NE Sec. 2 Twp. 11 Rge. 32 East West

4950 Ft North from Southeast Corner of Section
990 Ft West from Southeast Corner of Section
(Note: Locate well in section plat below)


Lease Name Keller Well # 1

Field Name.....

Producing Formation.....

Elevation: Ground 3053 KB 3058

Section Plat

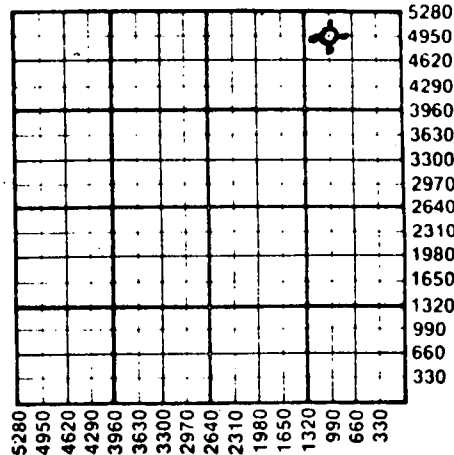

WATER SUPPLY INFORMATION

Disposition of Produced Water: Disposal
Docket # Repressuring

Questions on this portion of the ACO-1 call:
Water Resources Board (913) 296-3717

Source of Water: Water well-B & B Drilling, Grinnell,
Division of Water Resources Permit # Kansas

Groundwater.....Ft North from Southeast Corner
(Well)Ft West from Southeast Corner of
Sec Twp Rge East West

Surface Water.....Ft North from Southeast Corner
(Stream, pond etc).....Ft West from Southeast Corner
Sec Twp Rge East West

Other (explain).....
(purchased from city, R.W.D. #)

INSTRUCTIONS: This form shall be completed in duplicate and filed with the Kansas Corporation Commission, 200 Colorado Derby Building, Wichita, Kansas 67202, within 90 days after completion or recompletion of any well. Rule 82-3-130 and 82-3-107 apply. Information on side two of this form will be held confidential for a period of 12 months if requested in writing and submitted with the form. See rule 82-3-107 for confidentiality in excess of 12 months. One copy of all wireline logs and drillers time log shall be attached with this form. Submit CP-4 form with all plugged wells. Submit CP-111 form with all temporarily abandoned wells.

All requirements of the statutes, rules and regulations promulgated to regulate the oil and gas industry have been fully complied with and the statements herein are complete and correct to the best of my knowledge.

Signature John W. Wise
Title R & C Drilling Supt Date 21 April 86

Subscribed and sworn to before me this 21 day of April 1986
Notary Public Glenn M. Droits
Date Commission Expires May 6 - 86

GLENN M. DROITS
NOTARY PUBLIC
State of Kansas
My Appointment Expires 5-6-86

K.C.C. OFFICE USE ONLY
 Letter of Confidentiality Attached
 Wireline Log Received
 Drillers Timelog Received
Distribution
 KCC SWD/Rep NGPA
 KGS Plug Other
(Specify)

Sec 2 Twp 11 Rge 32 E