

TYPE

AFFIDAVIT OF COMPLETION FORM

ACO-1 WELL HISTORY

SIDE ONE

Two (2) copies of this form shall be filed with the Kansas Corporation Commission, 200 Colorado Derby Building, Wichita, Kansas 67202, within thirty (30) days after the completion of a well, regardless of how the well was completed.

F Attach separate letter of request if the information is to be held confidential. If confidential, only file one copy. Information on Side One will be of public record and Side Two will then be held confidential.

Applications must be made on dual completion, commingling, salt water disposal, injection and temporarily abandoned wells.

C Attach one copy only wireline logs (i.e. electrical log, sonic log, gamma ray neutron log, etc.). (Rules 82-2-105 & 82-2-125) KCC# (316) 263-3238.

LICENSE # 5364 EXPIRATION DATE 6/30/83

OPERATOR Beren Corporation API NO. 15-109-20,248-00-00

ADDRESS 970 Fourth Financial Center COUNTY Logan

Wichita, Kansas 67202 FIELD Wildcat

** CONTACT PERSON Tyler H. Sanders PROD. FORMATION
PHONE (316) 265-3311

PURCHASER NA LEASE Heyen

ADDRESS WELL NO. 1

WELL LOCATION C NW SE

DRILLING Murfin Drilling Company 1990 Ft. from south Line and

CONTRACTOR CONTRACTOR ADDRESS 617 Union Center Building 1990 Ft. from east Line of

Wichita, Kansas 67202 the SE (Qtr.) SEC 5 TWP 11S RGE 32W.

PLUGGING Murfin Drilling Company WELL PLAT

CONTRACTOR CONTRACTOR ADDRESS 617 Union Center Building

Wichita, Kansas 67202

TOTAL DEPTH 2770' PBTD

SPUD DATE 7/16/82 DATE COMPLETED 7/18/82

ELEV: GR 3083 DF KB 3088


DRILLED WITH (CABLE) (ROTARY) (AIR) TOOLS.

DOCKET NO. OF DISPOSAL OR REPRESSURING WELL BEING USED TO DISPOSE OF WATER FROM THIS LEASE

Amount of surface pipe set and cemented 322' DV Tool Used?

THIS AFFIDAVIT APPLIES TO: (Circle ONE) - Oil, Gas, Shut-in Gas, Dry, Disposal, Injection, Temporarily Abandoned, OWWO. Other

ALL REQUIREMENTS OF THE STATUTES, RULES AND REGULATIONS PROMULGATED TO REGULATE THE OIL AND GAS INDUSTRY HAVE BEEN FULLY COMPLIED WITH.

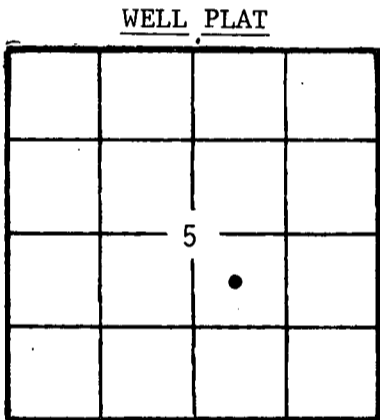

(Office Use Only) KCC KGS SWD/REP PLG.

A F F I D A V I T

Don W. Beauchamp, being of lawful age, hereby certifies that:

I am the Affiant, and I am familiar with the contents of the foregoing Affidavit. The statements and allegations contained therein are true and correct.

Don W. Beauchamp (Name)

SUBSCRIBED AND SWORN TO BEFORE ME this 11th day of August, 1982.

KAREN G. BERRY Notary Public, Sedwick County, Ks. My Appt. Exp. Nov. 4, 1984

MY COMMISSION EXPIRES: Nov. 4, 1984

RECEIVED (NOTARY PUBLIC) KAREN G. BERRY AUG 13 1982 STATE CORPORATION COMMISSION CONSERVATION DIVISION Wichita, Kansas

** The person who can be reached by phone regarding questions concerning this information.

SIDE TWO

ACO-1 WELL HISTORY

OPERATOR Beren Corporation

LEASE

Heyen

SEC. 5 TWP. 11S RGE. 32W

FILL IN WELL INFORMATION AS REQUIRED:

WELL NO. 1

Show all important zones of porosity and contents thereof; cored intervals, and all drill-stem tests, including depth interval tested, cushion used, time tool open, flowing and shut-in pressures, and recoveries.

SHOW GEOLOGICAL MARKERS, LOGS RUN, OR OTHER DESCRIPTIVE INFORMATION.

FORMATION DESCRIPTION, CONTENTS, ETC.	TOP	BOTTOM	NAME	DEPTH
Surface soil and sand	0	240		
Shale	240	322		
Sand and shale	322	2606		
Anhydrite	2606	2634		
Lime and shale	2634	2770		
RTD	2770			
NO DST'S RUN.				

Report of all strings set — surface, intermediate, production, etc. **CASING RECORD** (New) or (Used)

Purpose of string	Size hole drilled	Size casing set (in O.D.)	Weight lbs/ft.	Setting depth	Type cement	Sacks	Type and percent additives
Surface		8-5/8"		322'	60-40 Sunset	200	

LINER RECORD

PERFORATION RECORD

Top, ft.	Bottom, ft.	Sacks cement	Shots per ft.	Size & type	Depth interval

TUBING RECORD		
Size	Setting depth	Packer set at

ACID, FRACTURE, SHOT, CEMENT SQUEEZE RECORD

Amount and kind of material used	Depth interval treated

Date of first production	Producing method (flowing, pumping, gas lift, etc.)	Gravity
--------------------------	---	---------

Estimated Production -I.P.	Oil bbls.	Gas MCF	Water %	Gas-oil ratio bbls.	CFPB
----------------------------	-----------	---------	---------	---------------------	------

Disposition of gas (vented, used on lease or sold)

Perforations