


Give All Information Completely
Make Required Affidavit
Mail or Deliver Report to:
Conservation Division
State Corporation Commission
212 No. Market
Wichita, Kansas

WELL PLUGGING RECORD

Trego County. Sec. 21 Twp. 11S Rge. (E) 25 (W)
Location as "NE/CNWxSWx" or footage from lines SW SW NE
Lease Owner Adair Oil Company
Lease Name GERSTNER Well No. 1
Office Address P. O. Box 7011; Wichita, Kansas
Character of Well (completed as Oil, Gas or Dry Hole) Dry Hole
Date well completed August 8, 19 68
Application for plugging filed (verbally) August 8, 19 68
Application for plugging approved (verbally) August 8, 19 68
Plugging commenced August 8, 19 68
Plugging completed August 8, 19 68
Reason for abandonment of well or producing formation Dry Hole

NORTH

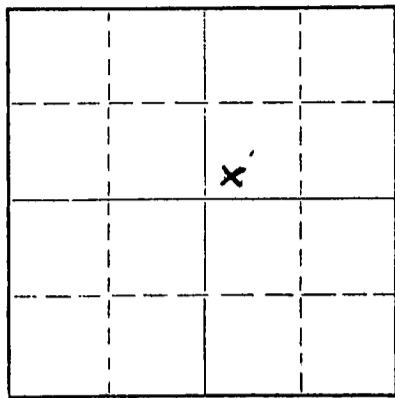

Locate well correctly on above Section Plat

If a producing well is abandoned, date of last production 19
Was permission obtained from the Conservation Division or its agents before plugging was commenced? Yes

Name of Conservation Agent who supervised plugging of this well Bill Nichols
Producing formation _____ Depth to top _____ Bottom _____ Total Depth of Well 4048 Feet
Show depth and thickness of all water, oil and gas formations.

OIL, GAS OR WATER RECORDS

CASING RECORD

FORMATION	CONTENT	FROM	TO	SIZE	PUT IN	PULLED OUT
				8-5/8"	214'	None

Describe in detail the manner in which the well was plugged, indicating where the mud fluid was placed and the method or methods used in introducing it into the hole. If cement or other plugs were used, state the character of same and depth placed, from _____ feet to _____ feet for each plug set.

1st Plug was set @1440' w/100 sx. cement;
2nd Plug was set @ 245' w/20 sx. cement;
Top Plug was set @ 40' w/10 sx. cement.

RECEIVED
STATE CORPORATION COMMISSION
8-15-1968
AUG 15 1968
CONSERVATION DIVISION
Wichita, Kansas

(If additional description is necessary, use BACK of this sheet)

Name of Plugging Contractor Abercrombie Drilling, Inc.
Address 801 Union Center; Wichita, Kansas

STATE OF KANSAS, COUNTY OF SEDGWICK, ss.
Jack K. Wharton (employee of owner) / of the above-described well, being first duly sworn on oath, says: That I have knowledge of the facts, statements, and matters herein contained and the log of the above-described well as filed and that the same are true and correct. So help me God.

(Signature) Jack K. Wharton
801 Union Center; Wichita, Kansas
(Address)

SUBSCRIBED AND SWORN TO before me this 12th day of August, 19 68.

My commission expires October 5, 1968
Mildred Saxton Notary Public.

15-195-20081-00-00

CONTRACTOR'S WELL LOG

OWNER: Adair Oil Company
 CONTRACTOR: Abercrombie Drilling, Inc.
 LEASE: GERSTNER #1
 LOCATION: SW SW NE, Sec. 21-11S-25W
 Trego County, Kansas
 SPUD DATE: July 31, 1968
 COMPLETION DATE: August 8, 1968

0	224	Sand & Shale
224	1639	Shale
1639	1845	Sand
1845	1885	Red Shale
1885	2070	Shale
2070	2111	Anhydrite
2111	2430	Shale
2430	2735	Shale w/Lime Streaks & Shells
2735	2840	Shale & Lime
2840	3645	Lime & Shale
3645	4048	Lime
	4048	R. T. D.

RECEIVED
 STATE CORPORATION COMMISSION
 8-15-1968
 AUG 15 1968
 CONSERVATION DIVISION
 Wichita, Kansas

Drilled 225' of 12-1/4" surface hole and set 8-5/8" csg. @214' w/160 sx. HA-5 cement.
 Plug was down 11:00 p.m., 7-31-63.
 Dry & Abandoned.

Elevation:

2482 K. B.
 2480 D. F.
 2474 G. L.

STATE OF KANSAS)
) SS
 COUNTY OF SEDGWICK)

Jack K. Wharton, Abercrombie Drilling, Inc., does hereby certify that the above and foregoing is a true and correct copy of the log of the #1 Gerstner, SW SW NE, Sec. 21-11S-25W, Trego County, Kansas.

Jack K. Wharton
 Jack K. Wharton

Sworn to before me, a Notary Public, in and for the County of Sedgwick, State of Kansas, as of this 13th day of August, 1968.

Mildred Saxton
 Mildred Saxton
 Notary Public

My Commission Expires:

October 5, 1968