


STATE OF KANSAS  
STATE CORPORATION COMMISSION

15-195-20517-00-00  
WELL PLUGGING RECORD

Give All Information Completely  
Make Required Affidavit  
Mail or Deliver Report to:  
Conservation Division  
State Corporation Commission  
212 North Market, Insurance Bldg.  
Wichita, Kansas

Trego County, Sec. 22 Twp. 11S Rge. 25W (E) (W)

Location as "NE/CNW/SW" or footage from lines NE NE NE  
Lease Owner John O. Farmer, Inc.  
Lease Name Ziegler Well No. #1  
Office Address Box 352 Russell, Kansas 67665  
Character of Well (completed as Oil, Gas or Dry Hole) Dry Hole  
Date well completed 12-1-78 19\_\_  
Application for plugging filed Yes 19\_\_  
Application for plugging approved 19\_\_  
Plugging commenced 19\_\_  
Plugging completed 4:30 P.M. 12-1-78 19\_\_  
Reason for abandonment of well or producing formation \_\_\_\_\_

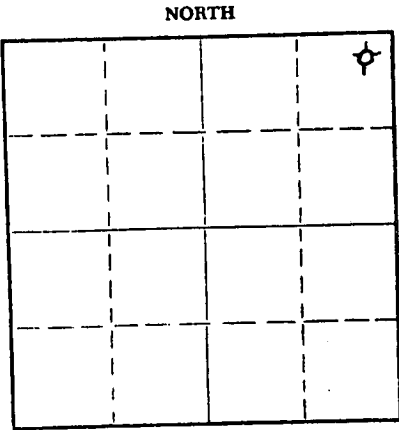

Locate well correctly on above Section Plat

If a producing well is abandoned, date of last production \_\_\_\_\_ 19\_\_  
Was permission obtained from the Conservation Division or its agents before plugging was commenced? Yes

Name of Conservation Agent who supervised plugging of this well Gilbert Balthazor  
Producing formation \_\_\_\_\_ Depth to top \_\_\_\_\_ Bottom \_\_\_\_\_ Total Depth of Well \_\_\_\_\_ Feet  
Show depth and thickness of all water, oil and gas formations.

OIL, GAS OR WATER RECORDS

CASING RECORD

FORMATION	CONTENT	FROM	TO	SIZE	PUT IN	PULLED OUT

Describe in detail the manner in which the well was plugged, indicating where the mud fluid was placed and the method or methods used in introducing it into the hole. If cement or other plugs were used, state the character of same and depth placed, from \_\_\_\_\_ feet to \_\_\_\_\_ feet for each plug set.

Plug #1 950/70 sx. Cement  
Plug #2 200/20 sx. Cement  
Plug #3 40/10 sx. Cement

RECEIVED  
STATE CORPORATION COMMISSION  
DEC - 6 1978  
12-6-1978  
CONSERVATION DIVISION  
Wichita, Kansas

(If additional description is necessary, use BACK of this sheet)  
Name of Plugging Contractor John O. Farmer, Inc.  
Address Box 352 Russell, Kansas 67665

STATE OF Kansas, COUNTY OF Russell, ss.  
John O. Farmer (employee of owner) or (owner or operator) of the above-described well, being first duly sworn on oath, says: That I have knowledge of the facts, statements, and matters herein contained and the log of the above-described well as filed and that the same are true and correct. So help me God.

(Signature) John O. Farmer  
Box 352 Russell, Kansas 67665  
(Address)

Subscribed and sworn to before me this 5th day of December, 1978



Helen Carlson  
Notary Public.

DESIGNATE TYPE OF COMP.: OIL, GAS, DRY HOLE, SWDW, ETC.:

Operator  
John O. Farmer, Inc.

Well No.  
#1

Lease Name  
Ziegler

Dry Hole

S 22 T11S R 25W<sup>E</sup><sub>W</sub>

**WELL LOG**

Show all important zones of porosity and contents thereof; cored intervals, and all drill-stem tests, including depth interval tested, cushion used, time tool open, flowing and shut-in pressures, and recoveries.

SHOW GEOLOGICAL MARKERS, LOGS RUN, OR OTHER DESCRIPTIVE INFORMATION.

FORMATION DESCRIPTION, CONTENTS, ETC.	TOP	BOTTOM	NAME	DEPTH
Surface	-0-	228	Log Tops:	2082' (+ 408)
Shale	228	750	Anhydrite	2123' (+ 367)
Shale & Sand	750	1450	Base	3562' (-1072)
Sand & Shale	1450	1975	Topeka	3782' (-1292)
Red Bed	1975	2082	Heebner	3801' (-1311)
Anhydrite	2082	2125	Toronto	3817' (-1327)
Shale & Shells	2125	2225	Lansing	4061' (-1571)
Shale & Lime	2225	2600	B/KC	4073' (-1583)
Lime & Shale	2600	2900	Log T.D.	4075' (-1585)
Shale & Lime	2900	3610	Rotary T.D.	
Shale	3610	3730		
Shale & Lime	3730	3880		
Lime	3880	4075		

USE ADDITIONAL SHEETS, IF NECESSARY, TO COMPLETE WELL RECORD.

Date Received

*John O. Farmer*  
Signature  
President  
Title

December 5, 1978  
Date

15-195-20517-00-00

**KANSAS DRILLERS LOG**

API No. 15 — 195 — 20,517-00-00  
 County Number

Operator  
John O. Farmer, Inc.

Address  
Box 352 Russell, Kansas 67665

Well No. #1 Lease Name Ziegler

Footage Location  
330 feet from (N) (S) line 330 feet from (E) (W) line

Principal Contractor John O. Farmer, Inc. Geologist Roger Welty

Spud Date 11-21-78 Total Depth 4075' P.B.T.D.


Date Completed 12-1-78 Oil Purchaser

S. 22 T. 11S R. 25W E W

Loc. NE NE NE

County Trego

640 Acres  
 N

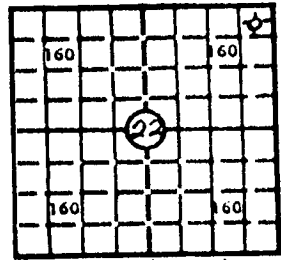

Locate well correctly

Elev.: Gr. 2485'

DF 2488' KB 2490'

**CASING RECORD**

Report of all strings set — surface, intermediate, production, etc.

Purpose of string	Size hole drilled	Size casing set (in O.D.)	Weight lbs/ft.	Setting depth	Type cement	Sacks	Type and percent additives
Surface	12 1/4	8-5/8	26	218	Common	175	

**LINER RECORD**

**PERFORATION RECORD**

Top, ft.	Bottom, ft.	Sacks cement	Shots per ft.	Size & type	Depth interval

Size	Setting depth	Packer set at

**ACID, FRACTURE, SHOT, CEMENT SQUEEZE RECORD**

Amount and kind of material used	Depth interval treated

RECEIVED  
 STATE CORPORATION COMMISSION  
 12-6-1978  
 DEC - 6 1978

**INITIAL PRODUCTION**

CONSERVATION DIVISION  
 Wichita, Kansas

Date of first production		Producing method (flowing, pumping, gas lift, etc.)			
RATE OF PRODUCTION PER 24 HOURS	Oil	Gas	Water	Gas-oil ratio	CFPB
	bbls.	bbls.	MCF	bbls.	
Disposition of gas (vented, used on lease or sold)			Producing interval (s)		

INSTRUCTIONS: As provided in KCC Rule 82-2-125, within 90 days after completion of a well, one completed copy of this Drillers Log shall be transmitted to the State Geological Survey of Kansas, 4150 Monroe Street, Wichita, Kansas 67209. Copies of this form are available from the Conservation Division, State Corporation Commission, 3830 So. Meridian (P.O. Box 17027), Wichita, Kansas 66217. Phone AC 316-522-2206. If confidential custody is desired, please note Rule 82-2-125. Drillers Logs will be on open file in the Oil and Gas Division, State Geological Survey of Kansas, Lawrence, Kansas 66044.