

STATE OF KANSAS
STATE CORPORATION COMMISSION

Form CP-4


Give All Information Completely
Make Required Affidavit
Mail or Deliver Report to:
Conservation Division
State Corporation Commission
212 No. Market
Wichita, Kansas 67202

15-195-20192-00-00
WELL PLUGGING RECORD

Trego County. Sec. 23 Twp. 11S Rge. 25W ~~XXX~~ ~~XXX~~

Location as "NE/CNW/SW" or footage from lines NW SW SE
Lease Owner Benjamin B. Tepper, Agent for Joe Katz Oil Account
Lease Name Connor Well No. 2
Office Address Suite 2E Cont. Bldg., 420 S. Dixie Hwy. Coral Gables Fla. 33146
Character of Well (completed as Oil, Gas or Dry Hole) Dry Hole
Date well completed September 4, 1971
Application for plugging filed Verbal Application
Application for plugging approved Verbal Approval
Plugging commenced September 4, 1971
Plugging completed September 4, 1971
Reason for abandonment of well or producing formation _____

If a producing well is abandoned, date of last production _____ 19____
Was permission obtained from the Conservation Division or its agents before plugging was commenced? Yes

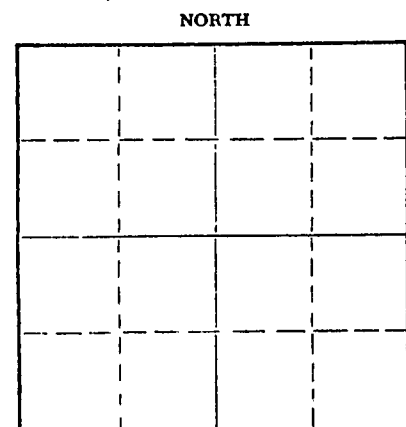

Locate well correctly on above Section Plat

Name of Conservation Agent who supervised plugging of this well W. L. Nichols
Producing formation _____ Depth to top _____ Bottom _____ Total Depth of Well 3,180 Feet
Show depth and thickness of all water, oil and gas formations.

OIL, GAS OR WATER RECORDS

CASING RECORD

FORMATION	CONTENT	FROM	TO	SIZE	PUT IN	PULLED OUT
				8-5/8"	209'	None

Describe in detail the manner in which the well was plugged, indicating where the mud fluid was placed and the method or methods used in introducing it into the hole. If cement or other plugs were used, state the character of same and depth placed, from _____ feet to _____ feet for each plug set.

Filled hole with heavy rotary mud from 3,180 feet (rotary total depth) to 1,150 feet. Set plug at 1,150 feet and cemented with 100 sacks cement. Filled hole with heavy rotary mud from 1,150 feet to 240 feet. Set plug at 240 feet and cemented with 25 sacks cement. Filled hole with heavy rotary mud from 240 feet to 40 feet. Set solid plug at 40 feet and cemented to cellar with 10 sacks cement, 2 sacks cement in rathole. Plugging operations accomplished utilizing Allied Cementing pump truck through 4 1/2 inch drill pipe.

RECEIVED
STATE CORPORATION COMMISSION
7-13-71
SEP 13 1971
CONSERVATION DIVISION
Wichita, Kansas

(If additional description is necessary, use BACK of this sheet)

Name of Plugging Contractor M-30, Inc.
Address 200 North Main, Wichita, Kansas 67202

STATE OF Kansas, COUNTY OF Sedgwick, ss.
Dean Britting, Agent (Employee of owner) or (Owner or operator) of the above-described well, being first duly sworn on oath, says: That I have knowledge of the facts, statements, and matters herein contained and the log of the above-described well as filed and that the same are true and correct. So help me God.

(Signature) Dean Britting
200 North Main, Wichita, Kansas 67202
(Address)

SUBSCRIBED AND SWORN to before me this 10th day of September, 19 71

Elsie Willison
Notary Public.

My commission expires June 30, 1971

15-195-20192-00-00
KANSAS GEOLOGICAL SOCIETY
 KANSAS WELL LOG BUREAU - KANSAS WELL SAMPLE BUREAU
 KANSAS GEOLOGICAL SOCIETY BUILDING
 508 EAST MURDOCK - WICHITA, KANSAS


COMPANY **Benjamin B. Tepper**
Agent for Joe Katz Oil Account
 FARM **Connor** NO. **2**

SEC. **23** T. **11S**, R. **25W**
 LOC. **NW SW SE**

TOTAL DEPTH **3,180'**
 COMM. **August 30, 1971** COMP. **September 4, 1971**

COUNTY **Trego**
 KANSAS

SHOT OR TREATED
 CONTRACTOR **H-30, Inc.**
 ISSUED

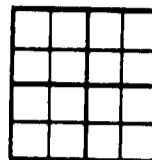

CASING
 20 10
 15 **8-5/8" 209' cemented w/150 sxs cement** ELEVATION **2503 KB**
 12 6
 13 5

PRODUCTION

FIGURES INDICATE BOTTOM OF FORMATIONS

Post Rock, Sand and Shale	209'
Shale with Lime Streaks	765'
Shale and Lime	1,450'
Shale	1,655'
Sand	1,875'
Shale	2,103'
Anhydrite	2,143'
Shale	2,202'
Shale and Lime	2,906'
Lime and Shale	3,106'
Shale and Lime	3,164'
Lime and Shale	3,180'
Rotary Total Depth	3,180'

I hereby certify the above and foregoing to be a true and correct log of the above described well as shown by the drilling reports.

H-30, INC.

Dean Britting

 Dean Britting

State of Kansas }
 County of Sedgwick } ss:

Subscribed and Sworn to before me a Notary Public in and for said county and state this 10th. day of September, 1971.

Elsie Willison

 Elsie Willison - Notary Public



RECEIVED
 STATE CORPORATION COMMISSION
 9-13-1971
 SEP 13 1971
 CONSERVATION DIVISION
 Wichita, Kansas