

STATE OF KANSAS
STATE CORPORATION COMMISSION

Form CP-4

Give All Information Completely
Make Required Affidavit
Mail or Deliver Report to:
Conservation Division
State Corporation Commission
212 No. Market
Wichita, Kansas 67202


WELL PLUGGING RECORD

Trego County, Sec. 23, Twp. 11S, Rge. (E) 25 (W)

Location as "NE/CNW/SW" or footage from lines 1320/FNL & 440/FEL of NE/4
Lease Owner Benjamin B. Tepper, Agent for Joe Katz & Assoc.

Lease Name Connor Well No. 1
Office Address 420 S. Dixie Highway, Coral Gables, Fla. 33146

Character of Well (completed as Oil, Gas or Dry Hole) Dry Hole
Date well completed April 17 19 70
Application for plugging filed Verbal Request 19
Application for plugging approved Verbal Approval 19
Plugging commenced April 17 19 70
Plugging completed April 17 19 70
Reason for abandonment of well or producing formation

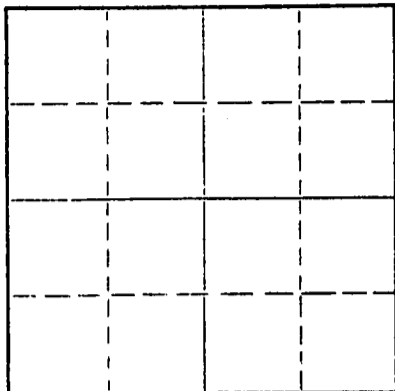

Locate well correctly on above Section Plat

If a producing well is abandoned, date of last production 19
Was permission obtained from the Conservation Division or its agents before plugging was commenced? Yes

Name of Conservation Agent who supervised plugging of this well W. L. Nichols

Producing formation Depth to top Bottom Total Depth of Well Feet

Show depth and thickness of all water, oil and gas formations.

OIL, GAS OR WATER RECORDS

CASING RECORD

| FORMATION | CONTENT | FROM | TO | SIZE | PUT IN | PULLED OUT |
|-----------|---------|------|----|--------|--------|------------|
| | | | | 8 5/8" | 208' | None |
| | | | | | | |
| | | | | | | |
| | | | | | | |
| | | | | | | |
| | | | | | | |
| | | | | | | |
| | | | | | | |
| | | | | | | |

Describe in detail the manner in which the well was plugged, indicating where the mud fluid was placed and the method or methods used in introducing it into the hole. If cement or other plugs were used, state the character of same and depth placed, from feet to feet for each plug set.

Filled hole with heavy rotary mud from 4,030 feet (rotary total depth) to 1,125 feet. Set bottom plug at 1,125 feet and cemented with 100 sacks cement. Filled hole with heavy rotary mud to 215 feet. Set plug at 215 feet and cemented with 25 sacks cement. Filled hole with heavy rotary mud to 40 feet. Set plug at 40 feet and cemented to cellar with 10 sacks cement, 2 sacks cement in rathole. Cementing service performed by Halliburton Pump Truck.

RECEIVED
STATE CORPORATION COMMISSION
4-22-1970
APR 22 1970
CONSERVATION DIVISION
Wichita, Kansas

Name of Plugging Contractor H-30, Inc.
Address 200 N. Main, Wichita, Kansas 67202

STATE OF KANSAS, COUNTY OF SEDGWICK, ss.
Arlo B. Romer (employee of owner) or (owner or operator) of the above-described well, being first duly sworn on oath, says: That I have knowledge of the facts, statements, and matters herein contained and the log of the above-described well as filed and that the same are true and correct. So help me God.

(Signature) Arlo B. Romer
200 N. Main St., Wichita, Kansas
(Address)

SUBSCRIBED AND SWORN to before me this 21 day of April, 19 70

Martha Hartpence
Notary Public.

My commission expires April 21, 1971



15-195-2055-00-00
KANSAS GEOLOGICAL SOCIETY
 KANSAS WELL LOG BUREAU - KANSAS WELL SAMPLE BUREAU
 KANSAS GEOLOGICAL SOCIETY BUILDING
 508 EAST MURDOCK - WICHITA, KANSAS


COMPANY Benjamin B. Tepper, Agent for
 Joe Katz & Associates
 FARM Connor NO. 1

SEC. 23 T. 11S R. 25W
 LOC. 1320' FNL & 440' FEL
 of NE/4

TOTAL DEPTH 4,030'
 COMM. April 9, 1970 COMP. April 17, 1970
 SHOT OR TREATED
 CONTRACTOR H-30, Inc.
 ISSUED

COUNTY Trego

KANSAS

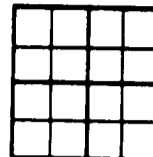

CASING

| | | |
|----|------|-------------------------------|
| 20 | 10 | |
| 15 | 5/8" | 208' cemented w/150 sx cement |
| 12 | 6 | |
| 13 | 5 | |

ELEVATION 2464' KB

PRODUCTION

FIGURES INDICATE BOTTOM OF FORMATIONS

| | |
|---------------------------|------|
| Surface Soil, Sand & Clay | 209 |
| Shale & Sand | 600 |
| Shale | 1610 |
| Sand & Red Bed | 1845 |
| Shale & Red Bed | 2055 |
| Anhydrite | 2098 |
| Shale & Shells | 2600 |
| Shale & Lime | 2830 |
| Lime | 2935 |
| Shale & Lime | 3160 |
| Lime & Shale | 3300 |
| Shale & Lime | 3430 |
| Lime & Shale | 3535 |
| Lime | 4030 |
| Rotary Total Depth | 4030 |

I hereby certify the above and foregoing to be a true and correct log of the above described well as shown by the drilling reports.

H-30, INC.

Arlo B. Romer

 Arlo B. Romer

STATE OF KANSAS }
 COUNTY OF SEDGWICK } SS:

Subscribed and Sworn to before me a Notary Public in and for said county and state this 21st day of April, 1970.

Martha Hartpence

 Martha Hartpence - Notary Public

My Commission Expires:

April 21, 1971

