


15-195-20202-00-00

STATE OF KANSAS
STATE CORPORATION COMMISSION

Form CP-4

WELL PLUGGING RECORD

Give All Information Completely
Make Required Affidavit
Mail or Deliver Report to:
Conservation Division
State Corporation Commission
P. O. Box 17027
Wichita, Kansas 67217
NORTH

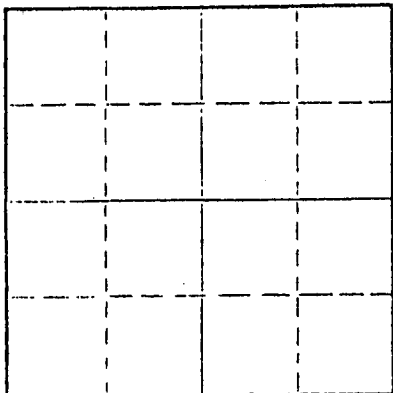

Locate well correctly on above
Section Plat

Trego County, Sec. 27 Twp. 11S Rge. 25W ~~EX~~ KWX
Location as "NE/CNWSW" or footage from lines: 1,320' from N line, 440' from
Lease Owner L.W. Bailey E Line, NE/4
Lease Name Ziegler Well No. 1
Office Address 200 No. Main, Wichita, Kansas 67202
Character of Well (completed as Oil, Gas or Dry Hole) Dry Hole
Date well completed February 1, 1972
Application for plugging filed Verbal Application 19__
Application for plugging approved Verbal Approval 19__
Plugging commenced February 1, 1972
Plugging completed February 1, 1972
Reason for abandonment of well or producing formation _____

If a producing well is abandoned, date of last production _____ 19__
Was permission obtained from the Conservation Division or its agents before plugging was com-
menced? Yes

Name of Conservation Agent who supervised plugging of this well W. L. Nichols
Producing formation _____ Depth to top _____ Bottom _____ Total Depth of Well 4,030 Feet
Show depth and thickness of all water, oil and gas formations.

OIL, GAS OR WATER RECORDS

CASING RECORD

FORMATION	CONTENT	FROM	TO	SIZE	PUT IN	PULLED OUT
				8-5/8"	209'	None

Describe in detail the manner in which the well was plugged, indicating where the mud fluid was placed and the method or methods used in introducing it into the hole. If cement or other plugs were used, state the character of same and depth placed, from _____ feet to _____ feet for each plug set.

Filled hole with heavy rotary mud from 4,030 feet (rotary total depth) to 1,150 feet. Set plug at 1,150 feet and cemented with 110 sacks cement. Filled hole with heavy rotary mud from 1,150 feet to 275 feet. Set plug at 275 feet and cemented with 30 sacks cement. Filled hole with heavy rotary mud from 275 feet to 40 feet. Set solid plug at 40 feet and cemented with 10 sacks cement, two sacks cement in rathole. Plugging operations accomplished utilizing Allied Oilwell Cementing pump truck through 4 1/2 inch drill pipe.

RECEIVED
STATE CORPORATION COMMISSION
FEB 14 1972
CONSERVATION DIVISION
Wichita, Kansas

(If additional description is necessary, use BACK of this sheet)
Name of Plugging Contractor H-30, Inc.
Address 200 North Main, Wichita, Kansas 67202

STATE OF Kansas COUNTY OF Sedgwick, ss.
Dean Britting, Agent ~~XXXXXX~~ of the above-described well being first duly sworn on oath, says: That I have knowledge of the facts, statements, and matters herein contained and the log of the above-described well as filed and that the same are true and correct. So help me God.

(Signature) Dean Britting
200 North Main, Wichita, Kansas 67202
(Address)

Subscribed and sworn to before me this 10th day of February, 1972

My commission expires June 30, 1974

Elsie Willison
Notary Public.



15-195-20202-00-00
KANSAS GEOLOGICAL SOCIETY
 KANSAS WELL LOG BUREAU - KANSAS WELL SAMPLE BUREAU
 KANSAS GEOLOGICAL SOCIETY BUILDING
 508 EAST MURDOCK - WICHITA, KANSAS

COMPANY **L. W. Bailey**

SEC. 27 T. 11S R. 25W
 LOC. 1,320' from N Line
 440' from E Line, NE/4


FARM **Ziegler**

NO. **1**

COUNTY **Trego**

TOTAL DEPTH **4,030'**
 COMM. **January 24, 1972**
 SHOT OR TREATED
 CONTRACTOR **H-30, Inc.**
 ISSUED

COMP. **February 1, 1972**

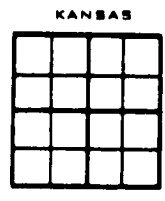

CASING

20	10	
15	8-5/8"	209' cemented w/150 sxs cement ELEVATION 2539' KB
12	6	
13	5	

PRODUCTION

FIGURES INDICATE BOTTOM OF FORMATIONS

Top Soil and Shale	211'
Shale	1,105'
Shale and Sand Stringers	1,645'
Shale	2,134'
Anhydrite	2,175'
Shale	2,312'
Shale and Lime	2,511'
Lime and Shale	2,760'
Lime	2,783'
Lime and Shale	3,770'
Lime	4,030'
Rotary Total Depth	4,030'

RECEIVED
 STATE CORPORATION COMMISSION
 FEB 14 1972
 CONSERVATION DIVISION
 Wichita, Kansas

I hereby certify the above and foregoing to be a true and correct log of the above described well as shown by the drilling reports.

H-30, INC.

Dean Britting

State of Kansas

County of Sedgwick

} SS:

Subscribed and Sworn to before me a Notary Public in and for said county and state this 10th. day of February, 1972.

Elsie Willison
 Elsie Willison - Notary Public

