


WELL PLUGGING RECORD

Give All Information Completely  
Make Required Affidavit  
Mail or Deliver Report to:  
Conservation Division  
State Corporation Commission  
800 Bitting Building  
Wichita, Kansas

Trego County, Sec. 36 Twp. 11 Rge. 25 (E) (W)

Location as "NE/CNW/SE/SW" or footage from lines G NW NW NW  
Lease Owner Virginia Drilling Co., Inc.  
Lease Name Schimkowitsch Well No. 1  
Office Address 701 Brown Bldg., Wichita 2, Kansas  
Character of Well (completed as Oil, Gas or Dry Hole) Dry  
Date well completed 3-8-54 19  
Application for plugging filed 3-8-54 19  
Application for plugging approved 3-8-54 19  
Plugging commenced 3-8-54 19  
Plugging completed 3-8-54 19  
Reason for abandonment of well or producing formation \_\_\_\_\_

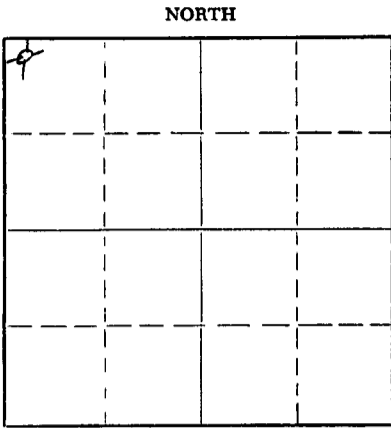

Locate well correctly on above  
Section Plat

If a producing well is abandoned, date of last production \_\_\_\_\_ 19\_\_\_\_  
Was permission obtained from the Conservation Division or its agents before plugging was commenced? yes

Name of Conservation Agent who supervised plugging of this well Eldon Petty  
Producing formation \_\_\_\_\_ Depth to top \_\_\_\_\_ Bottom \_\_\_\_\_ Total Depth of Well 4695 Feet  
Show depth and thickness of all water, oil and gas formations.

OIL, GAS OR WATER RECORDS

CASING RECORD

FORMATION	CONTENT	FROM	TO	SIZE	PUT IN	PULLED OUT
		0	238	8 5/8	242.97	none

Describe in detail the manner in which the well was plugged, indicating where the mud fluid was placed and the method or methods used in introducing it into the hole. If cement or other plugs were used, state the character of same and depth placed, from \_\_\_\_\_ feet to \_\_\_\_\_ feet for each plug set.

Mudded to 235 - set plug with 15 sx cement  
" " 40 - set plug with 10 sx cement

(If additional description is necessary, use BACK of this sheet)

Name of Plugging Contractor Virginia Drilling Co., Inc.  
Address 701 Brown Bldg., Wichita 2, Kansas


STATE OF Kansas, COUNTY OF Sedgwick, ss.  
S. A. Murphy (employee of owner) or (owner or operator) of the above-described well, being first duly sworn on oath, says: That I have knowledge of the facts, statements, and matters herein contained and the log of the above-described well as filed and that the same are true and correct. So help me God.

(Signature) [Signature]  
701 Brown Bldg., Wichita 2, Kansas  
(Address)

SUBSCRIBED AND SWORN TO before me this 10<sup>th</sup> day of March, 1954  
[Signature] Notary Public.

My commission expires Feb 5, 1957

3-15-1954

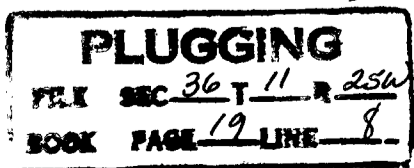

15-195-00358-00-00

Schimkowitz # 1 - C NW NW NW/4 Section 36-11s-25w Trego County, Kansas  
Company - Virginia Drilling Co., Inc.

Contractor - same

Commenced - February 17, 1954

Completed - March 8, 1954

Elevation - 2527 DF

Total Depth - 4695

8 5/8" set at 238 ft.

FORMATION	DEPTH	TOPS:
Shale - sand	0- 40	
Shale - shells	40- 238	
Shale	238-1000	
Sand - shale	1000-1225	
Shale - shells	1225-1370	3850 - Heebner
Sand - shale	1370-2125	3873 - Toronto
Shale - shells	2125-2130	3883 - Lansing KC
Anhydrite	2130-2173	4131 - Base KC
Shale - shells	2173-2290	4434 - Conglomerate
Shale - ruff shells	2290-2570	4450- Mississippi
Shale - lime	2570-2705	4596 - Viola
Shale - shells	2705-2960	4661 - Arbuckle
Lime - shale	2960-3035	
Shale - shells	3035-3270	
Lime- shale	3270-3430	
Shale - shells	3430-3500	
Lime	3500-3905	
Lime - shale	3905-3960	
Lime	3960-4195	
Lime - shale	4195-4401	
Lime	4401-4465	
Lime - chert	4465-4540	
Chert	4540-4545	
Lime - chert	4545-4580	
Lime	4580-4695 TD.	

*S. A. Murphy*  
-----  
S. A. Murphy

Subscribed and sworn to before me, a Notary Public,  
this 10th day of March, 1954.

*W. A. Hart*  
-----  
Notary Public

My commission expires: February 5, 1957.

**PLUGGING**  
BOOK PAGE 19 LINE 8

3-15-1954