

15-109-00027-00-00

STATE OF KANSAS
STATE CORPORATION COMMISSION

WELL PLUGGING RECORD


Give All Information Completely
Make Required Affidavit
Mail or Deliver Report to:
Conservation Division
State Corporation Commission
800 Biting Building
Wichita, Kansas

OR

FORMATION PLUGGING RECORD

Strike out upper line
when reporting plug-
ging off formations.

Logan County. Sec. 15 Twp. 11 Rge. 32 (W)
Location as "NE 1/4 NW 1/4 SW 1/4" or footage from lines SE SE SE
Lease Owner Skiles Oil Corporation
Lease Name Sharp Well No. 1
Office Address Box 166, Hutchinson, Kansas
Character of Well (completed as Oil, Gas or Dry Hole) dry
Date well completed February 7, 1952
Application for plugging filed February 12, 1952
Application for plugging approved February 13, 1952
Plugging commenced February 28, 1952
Plugging completed March 8, 1952
Reason for abandonment of well or producing formation dry

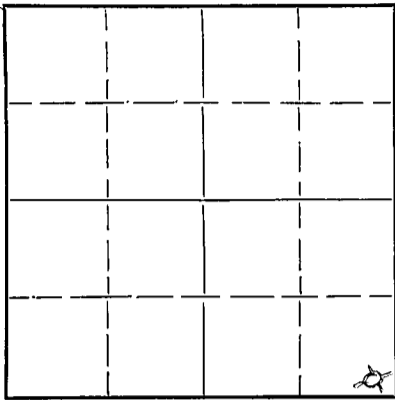

Locate well correctly on above
Section Plat

If a producing well is abandoned, date of last production 19...
Was permission obtained from the Conservation Division or its agents before plugging was com-
menced? yes

Name of Conservation Agent who supervised plugging of this well Eldon Petty
Producing formation Depth to top Bottom Total Depth of Well 4761 Feet
Show depth and thickness of all water, oil and gas formations.

OIL, GAS OR WATER RECORDS

CASING RECORD

Formation	Content	From	To	Size	Put In	Pulled Out
				10 3/4"	176'	none
				5 1/2"	4690	1500'

Describe in detail the manner in which the well was plugged, indicating where the mud fluid was placed and the method or methods used in introducing it into the hole. If cement or other plugs were used, state the character of same and depth placed, from...feet to...feet for each plug set.

Hole filled with heavy mud to bottom of surface pipe;
25 sacks cement in bottom of surface pipe; pipe filled
with mud; cemented in top with 12 sacks.

3-12-1952

(If additional description is necessary, use BACK of this sheet)

Correspondence regarding this well should be addressed to Raymond Gear, District Manager, Skiles Oil Corp.
Address Box 166, Hutchinson, Kansas

STATE OF Kansas, COUNTY OF Reno, ss.
Raymond Gear (employee of owner) or (owner or operator) of the above-described well,

being first duly sworn on oath, says: That I have knowledge of the facts, statements, and matters herein contained and the log of the above-described well as filed and that the same are true and correct. So help me God.

(Signature) Raymond Gear
Box 166, Hutchinson, Kansas (Address)

SUBSCRIBED AND SWORN to before me this 10th day of March, 1952

Wilma A. Clark
Notary Public.

My commission expires November 16, 1953

22-2625 2-48-15M

PLUGGING
FILE SEC 15 T 11 R 22W
PAGE 143 LINE 44

15-109-00027-00-00

W E L L L O G

SHARP #1

SE SE SE Section 15-21-32
Logan County, Kans.

COMPANY:

Skiles Oil Corporation
Company tools

COMMENCED:

November 18, 1951

COMPLETED:

February 7, 1952

CASING:

Set 176' of 10 3/4"
cemented with 200 sacks

Set 4690' of 5 1/2"
cemented with 185 sacks

ELEVATION:

3047 K. B.

<u>FORMATION</u>	<u>DEPTH</u>		<u>TOPS</u>	
Surface sand	250	Topoka lime	3790	-743
Shale and shells	1670			
Shale and sand	2030	Keokuk shale	4042	-995
Shale and lime	2665			
Shale, lime and salt	2945	Lansing - Kansas		
Shale and lime	3590	City lime	4064	-1017
lime	3668			
Sand, shale and lime	3757	Harnett	4352	-1305
Lime and shale	3829			
Lime and sand	3898	Patterson sand	4629	-1582
Lime and shale	3969			
lime	4268	Mississippi lime	4657	-1610
lime and shale	4296			
lime	4641			
lime and sand	4668			
lime	4761			
Total depth - rotary	4761			

DRY AND ABANDONED

PLUGGING

FILE SEC 15 T 11 R 320

PAGE 143 LINE 44

5-12-1952

I, Raymond Gear, certify the above to be a true and correct copy of the Driller's Log of the said well, according to the records of this office.

Raymond Gear
Raymond Gear