

FOR KCC USE:

PERMIT EXTENSION

FORM C-1 7/91

FORM MUST BE TYPED

FORM MUST BE SIGNED

ALL BLANKS MUST BE FILLED

EFFECTIVE DATE: 11-18-98

DISTRICT # 4

SGA? Yes No

State of Kansas

NOTICE OF INTENTION TO DRILL

Must be approved by the K.C.C. five (5) days prior to commencing well.

Expected Spud Date 11-24-98 month day year

Spot 50 W NE- NE- NE- Sec 31 Twp 11 S, Rg 33 East West

OPERATOR: License # 9482 Name: National Petroleum Reserves, Inc. Address: 250 N. Rock Rd #130 Wichita, KS 67206 Contact Person: Ted C. Bredehoff Phone: 316-681-3515

330 feet from South (North) line of Section 380 feet from East / West line of Section IS SECTION X REGULAR IRREGULAR?

(NOTE: Locate well on the Section Plat on Reverse Side) County: Logan

Lease Name: FOUQUET Well #: 1

Field Name: WC

Is this a Prorated/Spaced Field? yes no

Target Formation(s): LKC, Johnson Zn

Nearest lease or unit boundary: 330

Ground Surface Elevation: 3134 feet MSL

Water well within one-quarter mile: yes X no

Public water supply well within one mile: yes X no

Depth to bottom of fresh water: 700

Depth to bottom of usable water: 1640

Surface Pipe by Alternate: 1 XX 2 320'

Length of Surface Pipe Planned to be set:

Length of Conductor pipe required:

Projected Total Depth: 4750'

Formation at Total Depth: MISS

Water Source for Drilling Operations:

(APPLY FOR FROM DWR)

CONTRACTOR: License #: Undetermined Name:

Well Drilled For: Well Class: Type Equipment:

- X Oil Enh Rec Infield X Mud Rotary Gas Storage Pool Ext Air Rotary OWWO Disposal XX Wildcat Cable Seismic; # of Holes Other

If OWWO: old well information as follows: Operator: Well Name: Comp. Date: Old Total Depth

Directional, Deviated or Horizontal wellbore? yes X no If yes, true vertical depth: Bottom Hole Location:

Will Cores Be Taken? yes X no If yes, proposed zone:

AFFIDAVIT

The undersigned hereby affirms that the drilling, completion and eventual plugging of this well will comply with K.S.A. 55-101, et. seq. It is agreed that the following minimum requirements will be met:

- 1. Notify the appropriate district office prior to spudding of well; 2. A copy of the approved notice of intent to drill shall be posted on each drilling rig; 3. The minimum amount of surface pipe as specified below shall be set by circulating cement to the top; in all cases surface pipe shall be set through all unconsolidated materials plus a minimum of 20 feet into the underlying formation; 4. If the well is dry hole, an agreement between the operator and the district office on plug length and placement is necessary prior to plugging; 5. The appropriate district office will be notified before well is either plugged or production casing is cemented in; 6. IF AN ALTERNATE II COMPLETION, PRODUCTION PIPE SHALL BE CEMENTED FROM BELOW ANY USABLE WATER TO SURFACE WITHIN 120 DAYS OF SPUD DATE. IN ALL CASES, NOTIFY DISTRICT OFFICE PRIOR TO ANY CEMENTING.

I hereby certify that the statements made herein are true and to the best of my knowledge and belief.

Date: 11/10/98 Signature of Operator or Agent: Title: President

FOR KCC USE: API # 15- 109-206760000 Conductor pipe required NONE feet Minimum surface pipe required 250 feet per Alt. X(2) Approved by: JK 11-13-98 / EXT 3-15-99 This authorization expires: 5-13-99 / EXP 11-13-99 (This authorization void if drilling not started within 6 months of effective date.) Spud date: Agent:

31 11 330 PRO FORM 12 P. 1-21 11-13-1998 KANSAS OIL AND GAS COM.

- REMEMBER TO: File Drill Pit Application (form CDP-1) with Intent to Drill; File Completion Form ACO-1 within 120 days of spud date; File acreage attribution plat according to field proration orders; Notify appropriate district office 48 hours prior to workover or re-entry; Submit plugging report (CP-4) after plugging is completed; Obtain written approval before disposing or injecting salt water.

IN ALL CASES PLOT THE INTENDED WELL ON THE PLAT BELOW

PLAT OF ACREAGE ATTRIBUTABLE TO A WELL IN A PRORATED OR SPACED FIELD

If the intended well is in a prorated or spaced field, please fully complete this side of the form. If the intended well is in a prorated or spaced field complete the plat below showing that the well will be properly located in relationship to other wells producing from the common source of supply. Please show all the wells within 1 mile of the boundaries of the proposed acreage attribution unit for gas wells and within 1/2 mile of the boundaries of the proposed acreage attribution unit for oil wells.

API NO. 15- _____
 OPERATOR _____
 LEASE _____
 WELL NUMBER _____
 FIELD _____

LOCATION OF WELL: COUNTY _____
 _____ feet from south/north line of section
 _____ feet from east/west line of section
 SECTION _____ TWP _____ RG _____


NUMBER OF ACRES ATTRIBUTABLE TO WELL _____
 QTR/QTR/QTR OF ACREAGE _____

IS SECTION _____ REGULAR or _____ IRREGULAR
IF SECTION IS IRREGULAR, LOCATE WELL FROM NEAREST CORNER BOUNDARY.


Section corner used: _____ NE _____ NW _____ SE _____ SW

PLAT

(Show location of the well and shade attributable acreage for prorated or spaced wells.)
 (Show footage to the nearest lease or unit boundary line.)

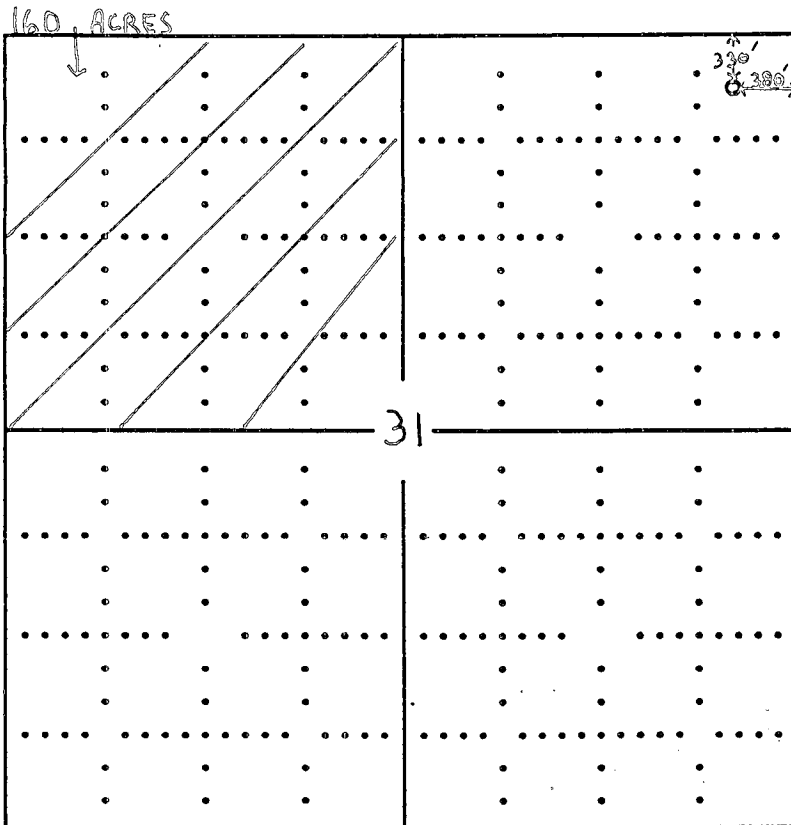

LOGAN CO.

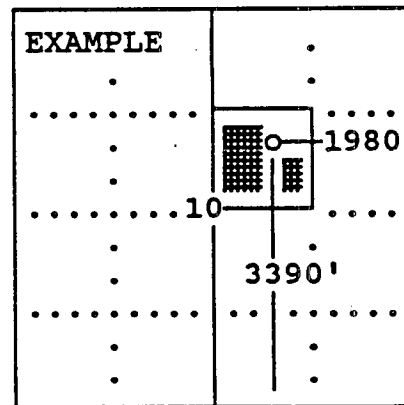

SEWARD CO.

In plotting the proposed location of the well, you must show:

- 1) The manner in which you are using the depicted plat by identifying section lines, i.e. 1 section, 1 section with 8 surrounding sections, 4 sections, etc.;
- 2) the distance of the proposed drilling location from the section's south/north and east/west; and
- 3) the distance to the nearest lease or unit boundary line.

15-109-20676-00-00

RECEIVED
KANSAS CORP COM
1999 MAR 9 3-9-1999
A 11:30

NATIONAL PETROLEUM RESERVES INC.

3/8/99

Kansas Corporation Commission
Conservation Division
130 N. Market, Rm 2078
Wichita, ks. 67202

Attention: David Williams


Re: Extension of Notice of Intent to Drill
Fouquet Lease, #1
API # 15-109-206760000

MR. Williams:

It is requested that the aforementioned
Notice of Intent to Drill be extended for
six (6) months following the authorization expiration
date.

Sincerely,

National Petroleum Reserves, Inc.

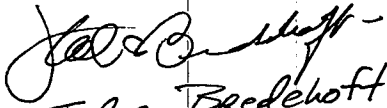By: 
Ted C. Bredehoff.