


WELL PLUGGING RECORD

Give All Information Completely  
Make Required Affidavit  
Mail or Deliver Report to:  
Conservation Division  
State Corporation Commission  
212 North Market, Insurance Bldg.  
Wichita, Kansas

Logan County, Sec. 11 Twp. 11S Rge. (E) 35 (W)

Location as "NE/CNW/SW" or footage from lines C NE NE  
Lease Owner Glenn W. Peel Drilling Co.  
Lease Name James Well No. 1  
Office Address R. R. #3, Box 144B, Wichita 20, Kansas  
Character of Well (completed as Oil, Gas or Dry Hole) Dry Hole  
Date well completed 2-12 19 61  
Application for plugging filed 2-11 19 61  
Application for plugging approved 2-11 19 61  
Plugging commenced 2-11 19 61  
Plugging completed 2-12 19 61  
Reason for abandonment of well or producing formation Dry Hole

NORTH

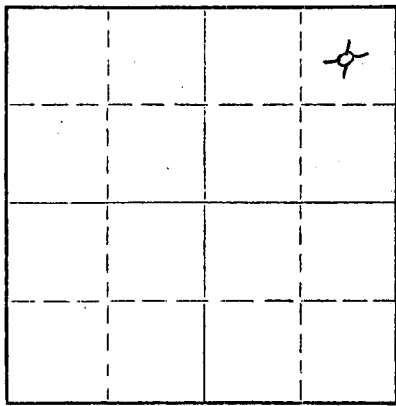

Locate well correctly on above  
Section Plat

If a producing well is abandoned, date of last production 19  
Was permission obtained from the Conservation Division or its agents before plugging was commenced? Yes

Name of Conservation Agent who supervised plugging of this well Gilbert P. Leiker  
Producing formation \_\_\_\_\_ Depth to top \_\_\_\_\_ Bottom \_\_\_\_\_ Total Depth of Well 4945 Feet  
Show depth and thickness of all water, oil and gas formations.

OIL, GAS OR WATER RECORDS

CASING RECORD

FORMATION	CONTENT	FROM	TO	SIZE	PUT IN	PULLED OUT
		0	260'	8 5/8"	260'	None

Describe in detail the manner in which the well was plugged, indicating where the mud fluid was placed and the method or methods used in introducing it into the hole. If cement or other plugs were used, state the character of same and depth placed, from \_\_\_\_\_ feet to \_\_\_\_\_ feet for each plug set.

From 4945' to 261 1/2' - Heavy Rotary Mud  
" 261 1/2' to 260' - Wooden plug  
" 260' to 198' - 20 sacks Cement & 1/2 sack Hulls  
" 198' to 41 1/2' - Heavy Rotary Mud  
" 41 1/2' to 40' - Wooden Plug  
" 40' to 6' - 10 sacks Cement & 1/2 sack Hulls  
" 6' to Surface - Cellar.

**RECEIVED**  
STATE CORPORATION COMMISSION  
2-17-1961  
FEB 17 1961  
CONSERVATION DIVISION  
Wichita, Kansas

(If additional description is necessary, use BACK of this sheet)

Name of Plugging Contractor \_\_\_\_\_  
Address \_\_\_\_\_


STATE OF KANSAS, COUNTY OF SEDGWICK, ss.  
William Herbert (employee of owner) or (owner or operator) of the above-described well, being first duly sworn on oath, says: That I have knowledge of the facts, statements, and matters herein contained and the log of the above-described well as filed and that the same are true and correct. So help me God.

(Signature) William Herbert  
R. R. #3, Box 144B, Wichita 20, Kansas  
(Address)

SUBSCRIBED AND SWORN to before me this 16th day of February, 19 61

My commission expires March 4, 1962

Minon M. Herbert  
Notary Public.

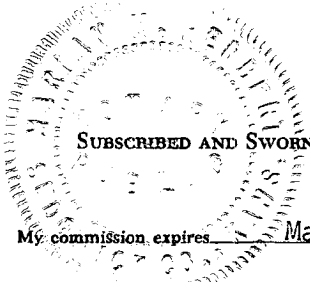

15-109-00042-00-00

DRILLER'S LOG

Company: Glenn W. Peel Drilling Co.

Location: C NE NE  
Sec. 11, Twp.: 11S, Rge.: 35W

Farm: James Well No. 1

County: Logan,  
Kansas

Total Depth: 4945'

Comm.: 1-26-61 Comp.: 2-12-61

Elevation:

Contractor: Glenn W. Peel Drilling Co.

Production: Dry

Casing: 8 5/8" @ 260' cem.

Figures below indicate bottom of formations

Surface clay	0 -	40'
Shale		140
Water sand		190
Shale		500
Shale & shells		1150
Shale w/anhydrite streaks		2040
Shale		2170
Anhydrite		2425
Shale w/anhydrite streaks		2465
Shale		2555
Shale & lime		2780
Shale		2810
Shale & lime		2975
Lime		3280
Shale w/lime streaks		3345
Lime		3580
Lime & shale		3660
Lime		3745
Lime & shale		4740
Lime		4780
Lime, sand & chert		4905
Lime		4915
Total Depth		4945

RECEIVED  
STATE CORPORATION COMMISSION  
2-17-1961  
FEB 17 1961  
CONSERVATION DIVISION  
Wichita, Kansas

This is to certify that the above information is to the best of my knowledge true and correct.

GLENN W. PEEL DRILLING COMPANY

BY: Way Herbert

SUBSCRIBED AND SWORN TO before me this 16th day of February, 1961.

My commission expires March 4, 1962.

Marion M. Herbert  
Notary Public

