

Notice: Fill out COMPLETELY and return to Conservation Division at the address below within 60 days from plugging date.

KANSAS CORPORATION COMMISSION OIL & GAS CONSERVATION DIVISION WELL PLUGGING RECORD K.A.R. 82-3-117

Form CP-4 December 2003 Type or Print on this Form Form must be Signed All blanks must be Filled

Lease Operator: LH Energy Address: 5460 White Oak Ave # A-330 Phone: (818) 788-7675 Operator License #: 7759

API Number: 15-001-02557-00-00 Lease Name: Day Well Number: Day #2

KCC PRT 207 CP2/3

Type of Well: oil Docket #: (Oil, Gas D&A, SWD, ENHR, Water Supply Well, Cathodic, Other) (If SWD or ENHR)

Spot Location (QQQQ): SW SW SE 423 Feet from North / South Section Line

The plugging proposal was approved on: 3/10/08 (Date) by: Clayton Title (KCC District Agent's Name)

2414 Feet from East / West Section Line Sec. 12 Twp. 25 S. R. 20 East West

Is ACO-1 filed? Yes No If not, is well log attached? Yes No

County: Allen

Producing Formation(s): List All (If needed attach another sheet) Bartlesv. Depth to Top: 790' Bottom: 800' T.D. 826'

Date Well Completed: 8/9/80 Plugging Commenced: 2/6/09 Plugging Completed: 2/6/09

Show depth and thickness of all water, oil and gas formations.

Table with columns: Oil, Gas or Water Records (Formation, Content) and Casing Record (Surface Conductor & Production) (From, To, Size, Put In, Pulled Out). Row 1: Bartlesv., Oil, surf., 900', 2", 900', 0.

Describe in detail the manner in which the well is plugged, indicating where the mud fluid was placed and the method or methods used in introducing it into the hole. If cement or other plugs were used, state the character of same depth placed from (bottom), to (top) for each plug set.

Run 1" pipe to TD (750') and circulate cement to surface. Used 22 sx. POH 1" pipe and filled from top. Total used 35 sx. Cut off pipe below plough depth.

KANSAS CORPORATION COMMISSION

MAY 11 2009

RECEIVED

Name of Plugging Contractor: Steve A. Becker dba A&A Well License #: 31813 Address: A&A Well Services, 4500 Connecticut Rd. Elsmore, KS 66732

Name of Party Responsible for Plugging Fees: LH Energy State of KANSAS County, MONTGOMERY, ss.

JURGEN J. HANKE (Employee of Operator) or (Operator) on above-described well, being first duly sworn on oath, says: That I have knowledge of the facts statements, and matters herein contained, and the log of the above-described well is as filed, and the same are true and correct, so help me God.

(Signature) Jurgen Hanke (Address) 2047 200 Rd Neodesha, KS 66757

SUBSCRIBED and SWORN TO before me this 6th day of May, 2009. Becky R. Hambleton My Commission Expires: 8/27/09

Mail to: KCC - Conservation Division, 130 S. Market - Room 2078, Wichita, Kansas 67202

BECKY R. HAMBLETON Notary Public - State of Kansas My Appt. Expires

A & A Well Service

Daily Operating Report

2/6, 09

Lease: Day

Rig #: Plug

Well #: 2

HAD HEAVY OIL IN WELL CANT GET CIRC. PULL OUT
300' WASH TO 775. Pump 22 SYD TOP TO BOTTOM

PULL UNIT

3 Hrs

WASH UNIT

1 Hr

WATER TRENCH

3 Hrs

PLUG UNIT

2 Hrs

KANSAS CORPORATION COMMISSION

MAY 11 2009

RECEIVED

RPC 885

CURRENT	1-30 DAYS PAST DUE	31-60 DAYS PAST DUE	61-90 DAYS PAST DUE
0.00	6,114.23	0.00	0.00

KANSAS CORPORATION COMMISSION

MAY 11 2009
RECEIVED

FILING NO

COMPANY PETRO-AMERICAN, INC.

WELL DAY NO. 2

FIELD

COUNTY ALLEN COUNTY, KANSAS

LOCATION: SW SW SE
SEC 12 TWP 25S RGE 20E


OTHER SERVICES:


PERMANENT DATUM... G.L.
LOG MEASURED FROM G.L. ELEV.
DRILLING MEASURED FROM G.L. FT ABOVE PERM. DATUM

ELEV. K.B.
D.F.
G.L.

DATE	8-9-80	8-9-80	8-9-80
RUN NO	1 NW	1 NW	1 NW
TYPE LOG	GAMMA RAY	NEUTRON	PERFORATE
DEPTH-DRILLER			
DEPTH-LOGGER	826'	826'	
BOTTOM LOGGED INTERVAL	820'	825'	
TOP LOGGED INTERVAL	512'	517'	
TYPE FLUID IN HOLE	WATER	WATER	WATER
DENSITY			
LEVEL	FULL	FULL	FULL
OPERATING RIG TIME			
RECORDED BY	LEONARD G. ILLIAS	LEONARD G. ILLIAS	LEONARD G. ILLIAS
WITNESSED BY			

RUN NO.	BORE-HOLE RECORD				CASING RECORD			
	BIT	FROM	TO	SIZE	WGT.	FROM	TO	
				2"		0	T.D.	

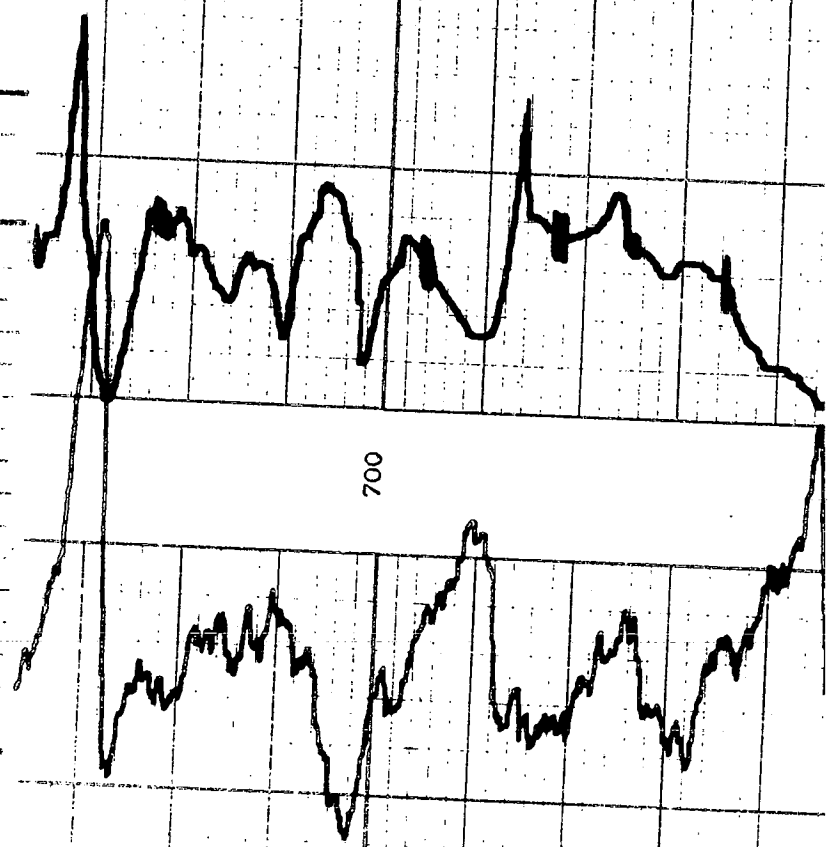

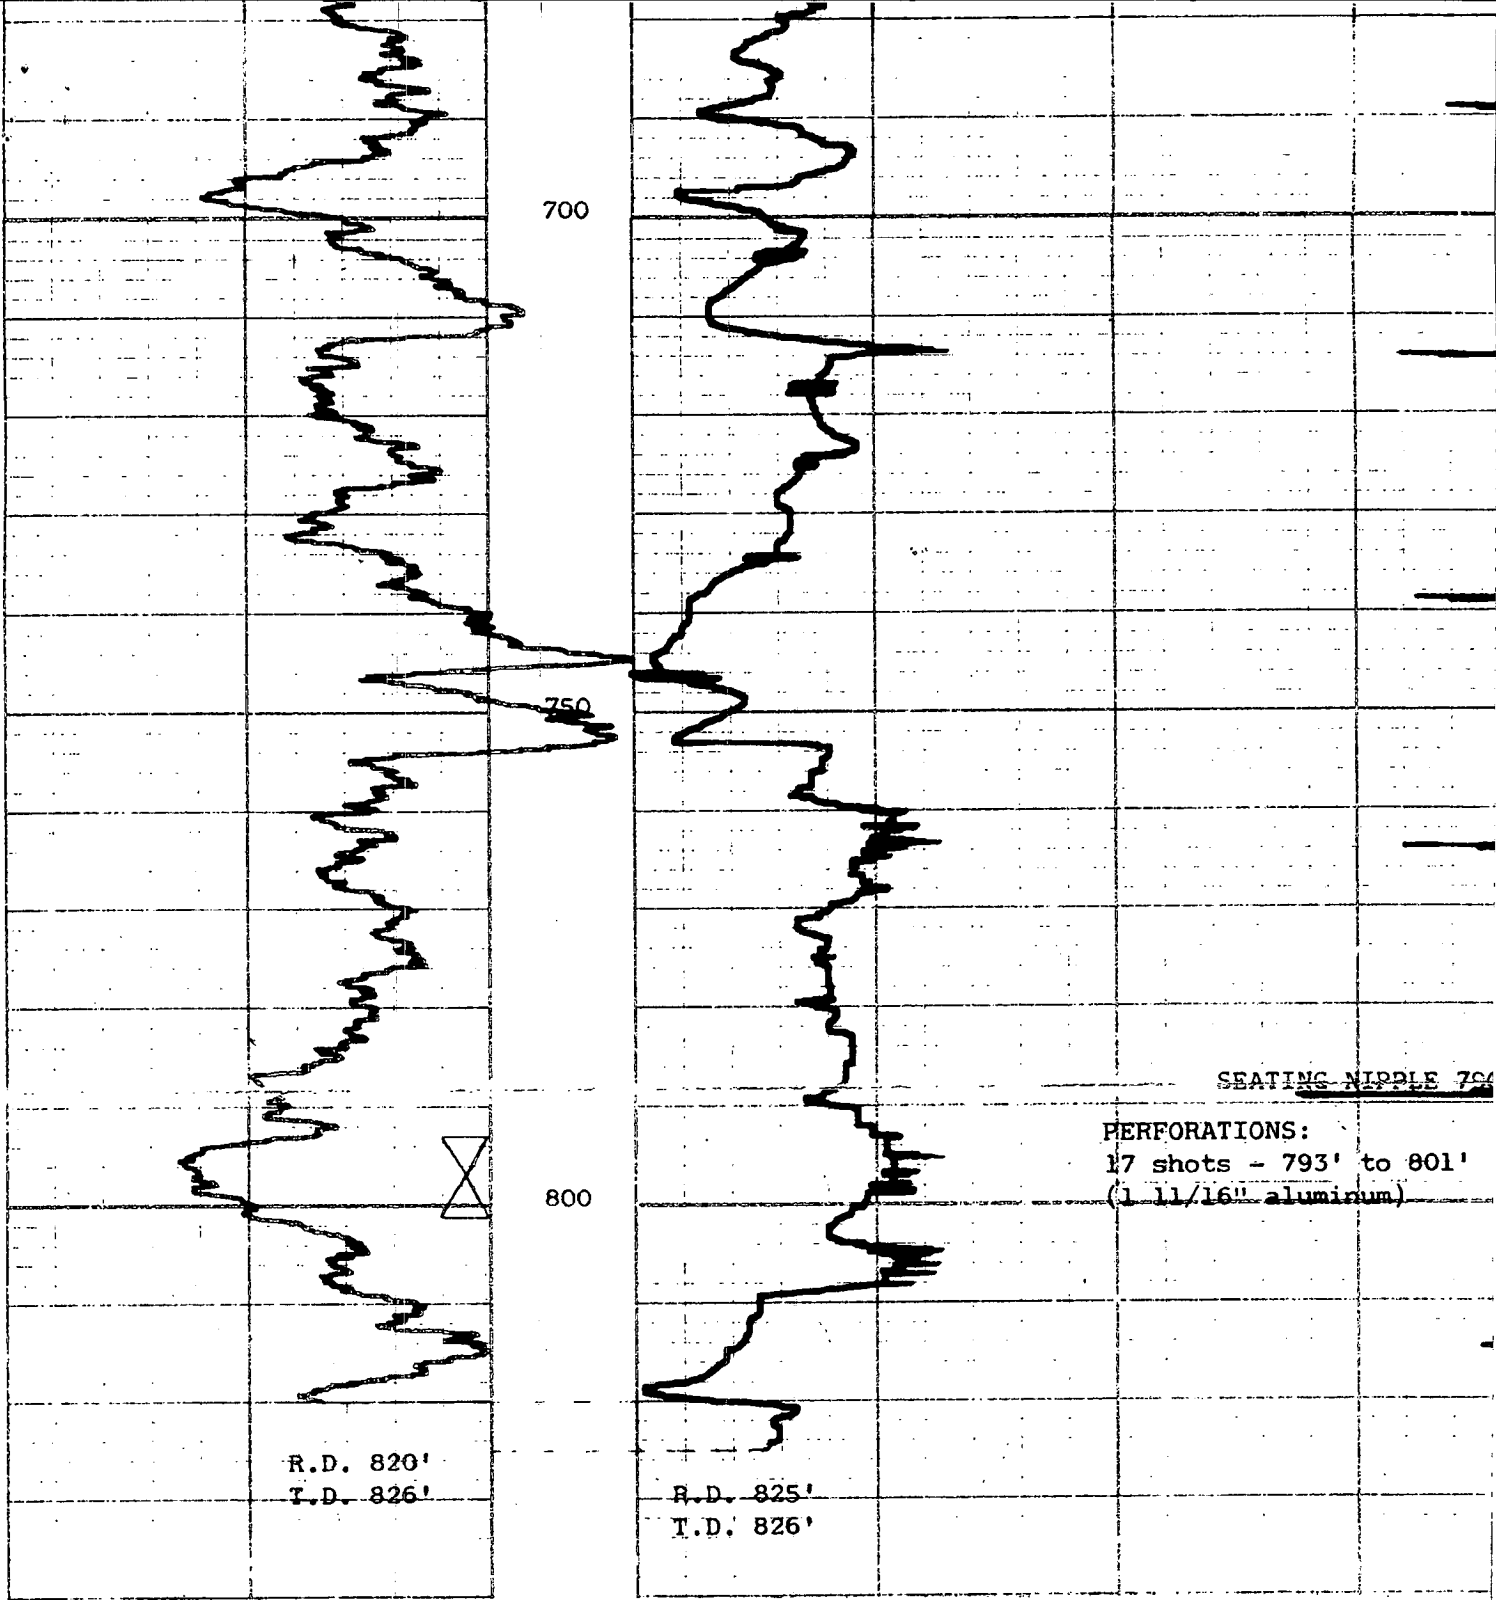

REPEAT SECTION

