


STATE OF KANSAS  
STATE CORPORATION COMMISSION

WELL PLUGGING RECORD

Give All Information Completely  
Make Required Affidavit  
Mail or Deliver Report to  
Conservation Division  
State Corporation Comm.  
245 North Water  
Wichita, KS 67202

Russell County, Sec. 6 Twp. 12S Rge. 14 E/W  
Location as "NE/CNW $\frac{1}{4}$ SW $\frac{1}{4}$ " or footage from lines

W/2 NE SE  
Lease Owner Rains & Williamson Oil Co., Inc.  
Lease Name Weilert Well No. 1  
Office Address 435 Page Court, 220 W. Douglas, Wichita, Ks.  
Character of Well (Completed as Oil, Gas or Dry Hole)

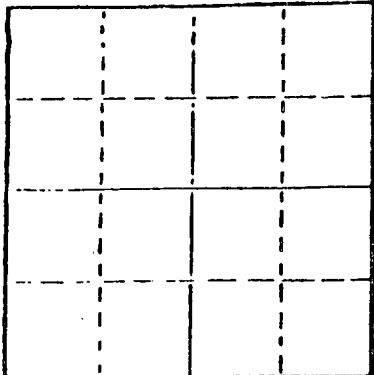

Locate well correctly on above  
Section Plat

Dry Hole  
Date Well completed 6-21-79 19  
Application for plugging filed 6-21-79 19  
Application for plugging approved 6-21-79 19  
Plugging commenced 6-21-79 19  
Plugging completed 6-21-79 19  
Reason for abandonment of well or producing formation  
Commercial quantities of oil not found  
If a producing well is abandoned, date of last production 19

Was permission obtained from the Conservation Division or  
its agents before plugging was commenced? yes

Name of Conservation Agent who supervised plugging of this well Duane Rankin, Great Bend, Ks.  
Producing formation \_\_\_\_\_ Depth to top \_\_\_\_\_ Bottom \_\_\_\_\_ Total Depth of Well 3310'  
Show depth and thickness of all water, oil and gas formations.

OIL, GAS OR WATER RECORDS

CASING RECORD

FORMATION	CONTENT	FROM	TO	SIZE	PUT IN	PULLED OUT
				8 5/8"	698'	None

Describe in detail the manner in which the well was plugged, indicating where the mud fluid was placed and the method or methods used in introducing it into the hold. If cement or other plugs were used, state the character of same and depth placed, from \_\_\_\_\_ feet to \_\_\_\_\_ feet for each plug set.

Plug @ 450'/50 sx  
Plug @ 40'/10 sx  
2 sx. in rat hole

RECEIVED  
STATE CORPORATION COMMISSION  
JUL 17 1979 07-11-79  
CONSERVATION DIVISION  
Wichita, Kansas

(If additional description is necessary, use BACK of this sheet)

Name of Plugging Contractor Buffalo Drilling Company, Inc.


STATE OF KANSAS COUNTY OF SEDGWICK, ss.  
WILSON RAINS of Buffalo Drilling Company, Inc. (employee of owner) or (owner or operator) of the above-described well, being first duly sworn on oath, says: That I have knowledge of the facts, statements, and matters herein contained and the log of the above-described well as filed and that the same are true and correct. So help me God.

(Signature) Wilson Rains  
435 Page Court, 220 W. Douglas, Wichita, Kans.  
(Address) 67202

SUBSCRIBED AND SWORN TO before me this 3rd day of July, 19

Juanita M. Green  
Juanita M. Green - Notary Public.

My commission expires October 4, 1979

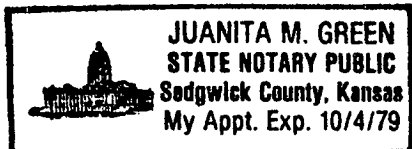

DRILLER'S LOG

COMPANY: Rains & Williamson Oil Co., Inc. SEC. 6 T. 12S R. 14W  
 WELL NAME: Weilert #1 LOC. W/2 NE SE COUNTY: Russell  
 RIG NO. 7  
 TOTAL DEPTH 3310' ELEVATION 1769' GR 1774' KB  
 COMMENCED: 6-13-79 COMPLETED: 6-21-79  
 CONTRACTOR: Buffalo Drilling Company, Inc.

CASING RECORD:

SURFACE: 8 5/8" @ 698'/225 sx 60-40 Poz., 2% gel + 150 sx Common, 2% gel, 3% CC.

PRODUCTION: D&A

LOG

(Figures Indicate Bottom of Formations)

Surface, Clay & Shale	295
Sand	364
Shale	700
Shale & Red Bed	856
Shale	2207
Shale & Shells	2711
Shale & Lime	2900
Lime	3310
Rotary Total Depth	3310

RECEIVED  
STATE CORPORATION COMMISSION

JUL 11 1979  
07-11-79  
CONSERVATION DIVISION  
Wichita, Kansas

STATE OF KANSAS )  
COUNTY OF SEDGWICK ) SS:

I, WILSON RAINS of Buffalo Drilling Company, Inc.  
upon oath state that the above and foregoing is a true and correct copy of the log of the  
Weilert #1 well.

*Wilson Rains*  
WILSON RAINS

Subscribed and sworn to before me this 3rd day of July, 1979.

My Appointment Expires  
October 4, 1979  
JUANITA M. GREEN  
STATE NOTARY PUBLIC  
Sedgwick County, Kansas  
My Appt. Exp. 10/4/79

*Juanita M. Green*  
JUANITA M. GREEN - NOTARY PUBLIC