

STATE OF KANSAS  
STATE CORPORATION COMMISSION

WELL PLUGGING RECORD

Give All Information Completely  
Make Required Affidavit  
Mail or Deliver Report to  
Conservation Division  
State Corporation Comm.  
245 North Water  
Wichita, KS 67202

Russell County. Sec. 6 Twp. 12 Rge. 14 E/W  
Location as "NE/CNW $\frac{1}{4}$ SW $\frac{1}{4}$ " or footage from lines C-N $\frac{1}{2}$ -SW


Lease Owner Weilert Enterprises  
Lease Name Steilow - Weilert Well No. 3  
Office Address Box 652 Hays, Kansas 67601  
Character of Well (Completed as Oil, Gas or Dry Hole) Dry hole

Date Well completed 11-12 1980  
Application for plugging filed 11-12 1980  
Application for plugging approved 11-12 1980  
Plugging commenced 11-12 1980  
Plugging completed 11-12 1980  
Reason for abandonment of well or producing formation dry hole

If a producing well is abandoned, date of last production 19

Was permission obtained from the Conservation Division or its agents before plugging was commenced?

Name of Conservation Agent who supervised plugging of this well Marion Schmidt  
Producing formation  Depth to top  Bottom  Total Depth of Well 3328'  
Show depth and thickness of all water, oil and gas formations.

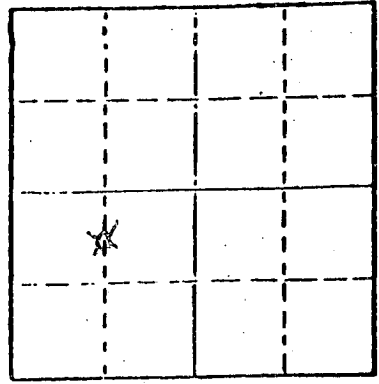

Locate well correctly on above Section Plat

OIL, GAS OR WATER RECORDS

CASING RECORD

FORMATION	CONTENT	FROM	TO	SIZE	PUT IN	PULLED OUT
Surface		0	219'	8 5/8"	218'	0

Describe in detail the manner in which the well was plugged, indicating where the mud fluid was placed and the method or methods used in introducing it into the hold. If cement or other plugs were used, state the character of same and depth placed, from  feet to  feet for each plug set.

1st Plug set at 480' with 50 sacks of cement 50-50 poz 2% gel

2nd plug set at 210' with 30 sacks of cement 50-50 poz 2% gel

3rd Plug set at 40' with 10 sacks of cement 50-50 poz 2% gel

5 sacks cement in rathole

(If additional description is necessary, use BACK of this sheet)

Name of Plugging Contractor Sun Oilwell Cementing

STATE OF Kansas COUNTY OF Graham, ss.  
Jerry M. Helberg (employee of owner) or (owner or operator)


of the above-described well, being first duly sworn on oath, says: That I have knowledge of the facts, statements, and matters herein contained and the log of the above-described well as filed and that the same are true and correct. So help me God.

(Signature) Jerry M. Helberg  
Box 32 Morland, Kansas 67650  
(Address)

SUBSCRIBED AND SWORN TO before me this 2nd day of December, 1980

Janice Notary Public.  
Conservation Division  
Wichita, Kansas

My commission expires 12-4-83

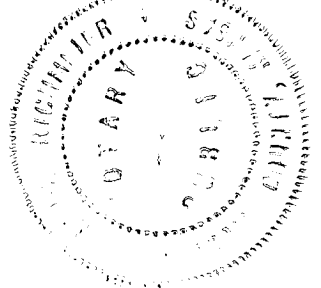

12-03-80

DRILLERS LOG  
STEILOW #3

CASING RECORD:

8 5/8" set at 218'

TOTAL DEPTH:

3328'

DESCRIPTION:

N $\frac{1}{2}$ -SW  
Sec. 6-12-14 Russell County, Ks.

OPERATOR: Weilert Enterprises

CONTRACTOR: Helberg Oil Co.

COMMENCED: November 2, 1980

COMPLETED: November 12, 1980

FORMATION	FROM	TO	RESULTS
Sand & Shale	0	219	
Sand & Shale	219	510	
Sand & Shale	510	864	
Shale	864	1210	
Shale	1210	1575	
Shale	1575	1734	
Shale	1734	1880	
Shale & Lime	1880	2025	
Shale & Lime	2025	2193	
Shale & Lime	2193	2320	
Shale & Lime	2320	2480	
Shale & Lime	2480	2638	
Lime	2638	2722	
Lime & Shale	2722	2794	
Lime & Shale	2794	2882	
Lime	2882	2956	
Lime	2956	2958	
Lime	2958	2983	
Lime	2983	3044	
Lime	3044	3051	
Lime	3051	3084	
Lime	3084	3140	
Lime	3140	3198	
Lime	3198	3270	
Lime	3270	3328	
T.D.	3328		

D&A

DEC - 3 1980  
CONSERVATION DIVISION  
Kansas  
12-03-80

I certify that the above is a true and correct copy of the log to the best of my knowledge.

HELBERG OIL COMPANY

*Jerry M. Helberg*  
Jerry M. Helberg

Subscribed and sworn to before me this 2 day of December, 1980.

*Jayne E. Morrison*  
Notary Public

My commission expires

