

15-167-30499-00-00

STATE OF KANSAS  
STATE CORPORATION COMMISSION

WELL PLUGGING RECORD

Give All Information Completely  
Make Required Affidavit  
Mail or Deliver Report to:  
Conservation Division  
State Corporation Commission  
800 Bitting Building  
Wichita, Kansas

Russell County, Sec. 8 Twp. 12 Rge. (E) 14 (W)

Location as "NE/CNW%SW%" or footage from lines SW/4 SE/4 SE/4

Lease Owner Gough Davis

Lease Name Fink Well No. #1

Office Address Wichita, Kansas

Character of Well (completed as Oil, Gas or Dry Hole) Dry Hole

Date well completed April 28 19 53

Application for plugging filed April 28 19 53

Application for plugging approved April 28 19 53


Plugging commenced April 28 19 53

Plugging completed April 28 19 53

Reason for abandonment of well or producing formation Dry Hole

If a producing well is abandoned, date of last production \_\_\_\_\_ 19 \_\_\_\_\_

Was permission obtained from the Conservation Division or its agents before plugging was commenced? yes

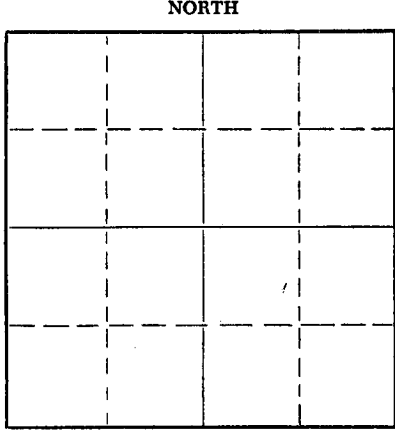

Locate well correctly on above Section Plat

Name of Conservation Agent who supervised plugging of this well C. D. Stough

Producing formation \_\_\_\_\_ Depth to top \_\_\_\_\_ Bottom \_\_\_\_\_ Total Depth of Well 3369 Feet

Show depth and thickness of all water, oil and gas formations.

OIL, GAS OR WATER RECORDS

CASING RECORD

FORMATION	CONTENT	FROM	TO	SIZE	PUT IN	PULLED OUT
				8-5/8"	158.61	none
				(Cemented top to Bottom)		

Describe in detail the manner in which the well was plugged, indicating where the mud fluid was placed and the method or methods used in introducing it into the hole. If cement or other plugs were used, state the character of same and depth placed, from 3369 feet to 0 feet for each plug set.

Filled hole with heavy rotary mud to 150'  
Set a bridging plug @ 150'  
Placed 1/2 Sack, Hulls on top of plug  
placed 15 sacks cement on top of Hulls  
Filled hole with heavy mud to 35'  
Set a bridging plug @ 35'  
Placed 1/2 sack hulls on top of plug.  
Placed 10 sacks cement on top of Hulls.  
to top of ground.

RECEIVED  
MAY 12 1953  
CONSERVATION DIVISION  
KANSAS  
05-08-53

(If additional description is necessary, use BACK of this sheet)


Name of Plugging Contractor Stearns Drilling Company  
Address Russell, Kansas

STATE OF Kansas, COUNTY OF Russell, ss.  
O. G. Stearns (employee of owner) or (owner or operator) of the above-described well, being first duly sworn on oath, says: That I have knowledge of the facts, statements, and matters herein contained and the log of the above-described well as filed and that the same are true and correct. So help me God.

(Signature) [Signature]  
Russell, Kansas  
(Address)

SUBSCRIBED AND SWORN TO before me this 5th day of May, 19 53  
My commission expires June 20, 1953  
Harold Arborek Notary Public.

PLUGGING  
FILE SEC 8 T. 12 R. 14W  
BOOK PAGE 98 LINE 14

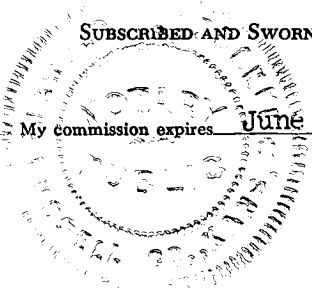

FINK #1

Operator: Gough Davis et. al.  
 Contractor: Stearns Drilling Company  
 Commencement Date: April 15, 1953  
 Completion Date: April 28, 1953

Location:  
 SW/4 SE/4 SE/4  
 Section 8-12-14  
 Russell County, Kansas

Casing Record:  
 8-5/8" 158.61' cemented with 100 sacks

WELL LOG

Gellar	0	5
Shale & Shells	5	320
Sand	320	345
Sand, Shale & Shells	345	525
Red Bed & Shale	525	635
Shale & Shells	635	835
Anhydrite	835	875
Shale & Shells	875	1430
Shale & Lime	1430	1475
Lime & Shale	1475	1900
Shale & Shells	1900	2045
Lime & Shale	2045	2887
Heebner Shale	2887	2891
Lime	2891	2893
Lime & Shale	2893	2937
Lime	2937	3227
Conglomerate	3227	3237
Lime	3237	3302
Conglomerate	3302	3369
Total Depth	3369	

STATE OF KANSAS )  
 ) SS  
 COUNTY OF RUSSELL )

I hereby certify that the above information is true and correct to the best of my knowledge.

*[Signature]*

SUBSCRIBED AND SWORN to before me this 7th day of May, 1953.

*Harold Hrbonek*  
 Notary Public

My Commission Expires: June 20, 1953



RECEIVED  
 THE COMMISSION

MAY - 3 1953

OBSERVATION DIVISION  
 Wichita, Kansas

PLUGGING

FILE SEC-8-T-12-R-14W  
 BOOK PAGE-98 LINE-14