

EFFECTIVE DATE: Must be approved by the K.C.C. five (5) days prior to commencing well

Expected Spud Date 11 3 1989
month day year

CS 1/2 SW SE Sec 20 Twp 12 S, Rg 14 East West

OPERATOR: License # 6194
Name: ESP DEVELOPMENT
Address: RR #1 Box #18
City/State/Zip: Paradise, Kansas 67658
Contact Person: Lewis Eulert
Phone: (913) 998-4413

330 feet from South line of Section
1980 feet from East line of Section
(Note: Locate well on Section Plat Below)

CONTRACTOR: License #: 4083
Name: Western Kansas Drilling

County: RUSSELL
Lease Name: PARADISE SOUTH Well #: 1
Field Name: (Mellard) UNKNOWN
Is this a Prorated Field? yes no
Target Formation(s): Lans Kans City
Nearest lease or unit boundary: 330
Ground Surface Elevation: feet MSL
Domestic well within 330 feet: yes no
Municipal well within one mile: yes no
Depth to bottom of fresh water: 180
Depth to bottom of usable water: 500
Surface Pipe by Alternate: 1 2
Length of Surface Pipe Planned to be set: 200
Length of Conductor pipe required: 0
Projected Total Depth: 3400
Formation at Total Depth: Arbuckle
Water Source for Drilling Operations:
... well ... farm pond other
DWR Permit #:
Will Cores Be Taken?: yes no
If yes, proposed zone:
Arbuckle

Well Drilled For: Well Class: Type Equipment:
 Oil ... Inj ... Infield Mud Rotary
... Gas ... Storage ... Pool Ext. ... Air Rotary
... OAWO ... Disposal Wildcat ... Cable
... Seismic; ... # of Holes

If OAWO: old well information as follows:

Operator:
Well Name:
Comp. Date: Old Total Depth

Directional, Deviated or Horizontal wellbore? yes no
If yes, total depth location:

AFFIDAVIT


The undersigned hereby affirms that the drilling, completion and eventual plugging of this well will comply with K.S.A. 55-101, et. seq.

It is agreed that the following minimum requirements will be met:

1. The appropriate district office shall be notified before setting surface pipe;
2. The minimum amount of surface pipe as specified above shall be set by circulating cement to the top; in all cases surface pipe shall be set through all unconsolidated materials plus a minimum of 20 feet into the underlying formation;
3. If the well is dry, a plugging proposal shall be submitted to the district office. An agreement between the operator and the district office on plug length and placement is necessary prior to plugging;
4. The appropriate district office will be notified before well is either plugged or production casing is cemented in;
5. If an Alternate II completion, production pipe shall be cemented from below any usable water to surface within 120 days of spud date. In all cases, notify district office prior to any cementing.

I hereby certify that the statements made herein are true and to the best of my knowledge and belief.

Date: 10-30-89 Signature of Operator or Agent: *Frank Breadfoot* Title: Agent

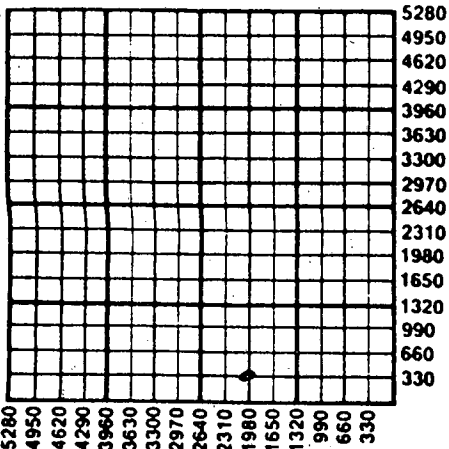

CONSERVATION DIVISION
Wichita, Kansas
OCT 30 1989
10-30-89

FOR KCC USE: D

API # 15-167-22,878
Conductor pipe required NONE feet
Minimum surface pipe required 200 feet per Alt. O
Approved by: DPW 10-30-89
EFFECTIVE DATE: 11-04-89
This authorization expires: 4-30-90
(This authorization void if drilling not started within 6 months of effective date.)
Spud date: Agent:

20
12
14W

REMEMBER TO:

- File Drill Pit Application (form CDP-1) with Intent to Drill;
- File Completion Form ACO-1 within 120 days of spud date;
- File acreage attribution plat according to field proration orders;
- Notify appropriate district office 48 hours prior to workover or re-entry;
- Submit plugging report (CP-4) after plugging is completed;
- Obtain written approval before disposing or injecting salt water.