

15-167-23200-00-00

For KCC Use: Effective Date: 9-3-2001 District # 4

KANSAS CORPORATION COMMISSION OIL & GAS CONSERVATION DIVISION

Form C-1 September 1999 Form must be Typed Form must be Signed All blanks must be Filled

NOTICE OF INTENT TO DRILL

Must be approved by KCC five (5) days prior to commencing well

Expected Spud Date September 1, 2001

Spot SE SW SW Sec. 2 Twp. 12 S. R. 15 East West XX feet from S N (circle one) Line of Section 330 feet from E W (circle one) Line of Section 990 Is SECTION X Regular Irregular?

OPERATOR: License# 4952 Name: Starr F. Schlobohm Address: 47 Michawanic Road, #3D City/State/Zip: Sanbornville, NH 03872-3787 Contact Person: (785) 483-9580 - John L. Driscoll Phone: Starr F. Schlobohm - (800) 498-4680

(Note: Locate well on the Section Plat on reverse side) County: Russell Lease Name: Saline River Ranch Well #: 1 Field Name: Fay Is this a Prorated / Spaced Field?  Yes  No

CONTRACTOR: License# 9531 9431 Name: Vonfeldt Drilling, Inc.

Target Formation(s): Arbuckle & Lansing/Kansas City Nearest Lease or unit boundary: 330' Ground Surface Elevation: 1,787' feet MSL Water well within one-quarter mile:  Yes  No Public water supply well within one mile:  Yes  No Depth to bottom of fresh water: 180' Depth to bottom of usable water: 400' 3/DAKOTA

Well Drilled For: Well Class: Type Equipment:  Oil  Enh Rec  Infield  Mud Rotary  Gas  Storage  Pool Ext.  Air Rotary  OWWO  Disposal  Wildcat  Cable  Seismic; # of Holes  Other

Surface Pipe by Alternate: X 1 2 Length of Surface Pipe Planned to be set: 975' Length of Conductor Pipe required: None Projected Total Depth: 3,250' Formation at Total Depth: Arbuckle Water Source for Drilling Operations: Well  Farm Pond  Other

If OWWO: old well information as follows: Operator: Well Name: Original Completion Date: Original Total Depth:

Directional, Deviated or Horizontal wellbore?  Yes  No If Yes, true vertical depth: Bottom Hole Location: KCC DKT #:

DWR Permit #: Saline River, permit applied for. (Note: Apply for Permit with DWR ) Will Cores be taken?  Yes  No

AFFIDAVIT

AUG 27 2001 08-27-2001 CONSERVATION DIVISION

The undersigned hereby affirms that the drilling, completion and eventual plugging of this well will comply with K.S.A. 55-101, et. seq. It is agreed that the following minimum requirements will be met:

- 1. Notify the appropriate district office prior to spudding of well;
2. A copy of the approved notice of intent to drill shall be posted on each drilling rig;
3. The minimum amount of surface pipe as specified below shall be set by circulating cement to the top; in all cases surface pipe shall be set through all unconsolidated materials plus a minimum of 20 feet into the underlying formation.
4. If the well is dry hole, an agreement between the operator and the district office on plug length and placement is necessary prior to plugging;
5. The appropriate district office will be notified before well is either plugged or production casing is cemented in;
6. If an ALTERNATE II COMPLETION, production pipe shall be cemented from below any usable water to surface within 120 days of spud date. In all cases, NOTIFY district office prior to any cementing.

I hereby certify that the statements made herein are true and to the best of my knowledge and belief. Date: August 22, 2001 Signature of Operator or Agent: Starr F. Schlobohm Title: Owner/Operator

For KCC Use ONLY API # 15 - 167-23200-0000 Conductor pipe required NONE feet Minimum surface pipe required 420 feet per Alt. (1) X Approved by: JK 8-29-2001 This authorization expires: 2-28-2002 (This authorization void if drilling not started within 6 months of effective date.) Spud date: Agent:

- Remember to: - File Drill Pit Application (form CDP-1) with Intent to Drill; - File Completion Form ACO-1 within 120 days of spud date; - File acreage attribution plat according to field proration orders; - Notify appropriate district office 48 hours prior to workover or re-entry; - Submit plugging report (CP-4) after plugging is completed; - Obtain written approval before disposing or injecting salt water.

2 12 15M

### IN ALL CASES PLOT THE INTENDED WELL ON THE PLAT BELOW

Plat of acreage attributable to a well in a prorated or spaced field

If the intended well is in a prorated or spaced field, please fully complete this side of the form. If the intended well is in a prorated or spaced field complete the plat below showing that the well will be properly located in relationship to other wells producing from the common source of supply. Please show all the wells and within 1 mile of the boundaries of the proposed acreage attribution unit for gas wells and within 1/2 mile of the boundaries of the proposed acreage attribution unit for oil wells.

API No. 15 - \_\_\_\_\_

Operator: Starr F. Schlobohm

Lease: Saline River Ranch

Well Number: 1

Field: Fay

Number of Acres attributable to well: 10

QTR / QTR / QTR of acreage: SE SW SW

Location of Well: County: Russell

330' feet from S N (circle one) Line of Section

990' feet from E W (circle one) Line of Section

Sec. 2 Twp. 12 S. R. 15  East  West

Is Section X Regular or \_\_\_\_\_ Irregular.



If Section is Irregular, locate well from nearest corner boundary.

Section corner used: NE NW SE SW

### PLAT

(Show location of the well and shade attributable acreage for prorated or spaced wells.)

(Show footage to the nearest lease or unit boundary line.)

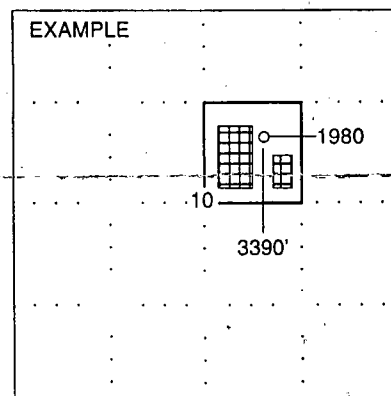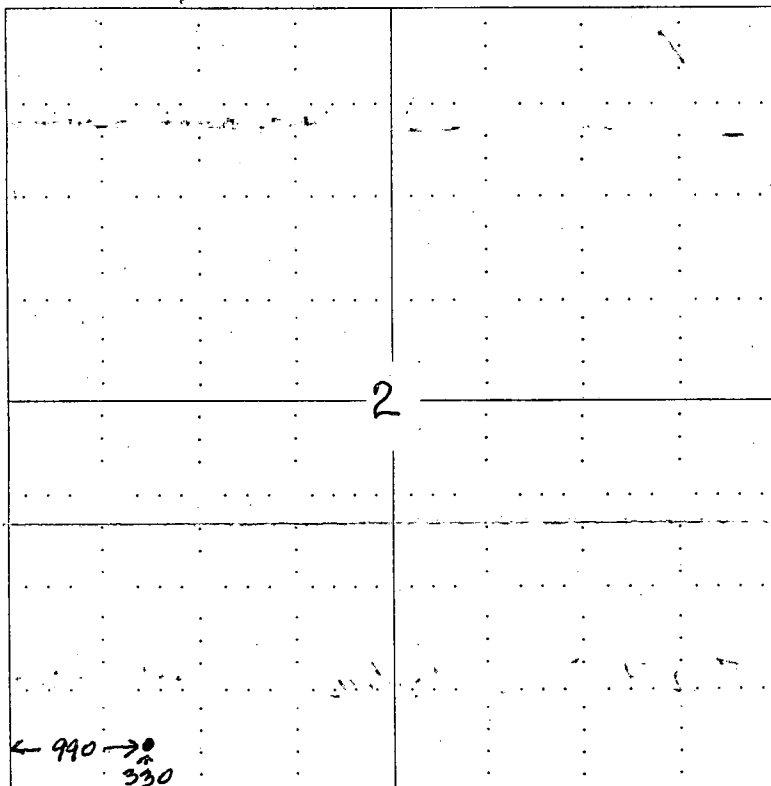

NOTE: In all cases locate the spot of the proposed drilling location.

#### In plotting the proposed location of the well, you must show:

1. The manner in which you are using the depicted plat by identifying section lines, i.e. 1 section, 1 section with 8 surrounding sections, 4 sections, etc.
2. The distance of the proposed drilling location from the section's south / north and east / west.
3. The distance to the nearest lease or unit boundary line.
4. If proposed location is located within a prorated or spaced field a certificate of acreage attribution plat must be attached: (CO-7 for oil wells; CG-8 for gas wells).