

15-167-23191-00-00

For KCC Use: Effective Date: 1-13-2001  
District #: 4  
SGA?  Yes  No

KANSAS CORPORATION COMMISSION  
OIL & GAS CONSERVATION DIVISION  
**NOTICE OF INTENT TO DRILL**

Form C-1  
September 1999  
Form must be Typed  
Form must be Signed  
All blanks must be Filled

Must be approved by KCC five (5) days prior to commencing well

Expected Spud Date January 15, 2001  
month day year

OPERATOR: License# 4952  
Name: Starr F. Schlobohm  
Address: 47 Michawanic Road, #3D  
City/State/Zip: Sanbornville, NH 03878-3787  
Contact Person: John L. Driscoll  
Phone: (785) 483-9580

CONTRACTOR: License# 9431  
Name: Vonfeldt Drilling, Inc.

Well Drilled For: Well Class: Type Equipment:  
 Oil  Enh Rec  Infield  Mud Rotary  
 Gas  Storage  Pool Ext.  Air Rotary  
 OWWO  Disposal  Wildcat  Cable  
 Seismic; # of Holes  Other

If OWWO: old well information as follows:  
Operator: \_\_\_\_\_  
Well Name: \_\_\_\_\_  
Original Completion Date: \_\_\_\_\_ Original Total Depth: \_\_\_\_\_

Directional, Deviated or Horizontal wellbore?  Yes  No  
If Yes, true vertical depth: \_\_\_\_\_  
Bottom Hole Location: \_\_\_\_\_  
KCC DKT #: \_\_\_\_\_

Spot  East  
 SE  SW  SW Sec. 2 Twp. 12 S. R. 15  West  
330 feet from S N (circle one) Line of Section  
990 feet from E W (circle one) Line of Section  
Is SECTION  Regular  Irregular?

(Note: Locate well on the Section Plat on reverse side)  
County: Russell  
Lease Name: Hoisington Well #: 1  
Field Name: FAY

Is this a Prorated / Spaced Field?  Yes  No  
Target Formation(s): Arbuckle & Lansing/Kansas City

Nearest Lease or unit boundary: 330'  
Ground Surface Elevation: 1,787' feet MSL

Water well within one-quarter mile:  Yes  No  
Public water supply well within one mile:  Yes  No

Depth to bottom of fresh water: 180'  
Depth to bottom of usable water: 400'

Surface Pipe by Alternate:  1  2  
Length of Surface Pipe Planned to be set: 975'

Length of Conductor Pipe required: None  
Projected Total Depth: 3,250'

Formation at Total Depth: Arbuckle  
Water Source for Drilling Operations:

Well \_\_\_\_\_ Farm Pond \_\_\_\_\_ Other   
DWR Permit #: Saline River, permit applied for.

(Note: Apply for Permit with DWR ) - Done.  
Will Cores be taken?  Yes  No  
If Yes, proposed zone: \_\_\_\_\_

**AFFIDAVIT**

The undersigned hereby affirms that the drilling, completion and eventual plugging of this well will comply with K.S.A. 55-101, et. seq. It is agreed that the following minimum requirements will be met:

1. Notify the appropriate district office **prior** to spudding of well;
2. A copy of the approved notice of intent to drill **shall be posted** on each drilling rig;
3. The minimum amount of surface pipe as specified below **shall be set** by circulating cement to the top; in all cases surface pipe **shall be set** through all unconsolidated materials plus a minimum of 20 feet into the underlying formation.
4. If the well is dry hole, an agreement between the operator and the district office on plug length and placement is necessary **prior to plugging**;
5. The appropriate district office will be notified before well is either plugged or production casing is cemented in;
6. If an ALTERNATE II COMPLETION, production pipe shall be cemented from below any usable water to surface within **120 days** of spud date. **In all cases, NOTIFY district office** prior to any cementing.

I hereby certify that the statements made herein are true and to the best of my knowledge and belief.

Date: 01/02/01 Signature of Operator or Agent: Starr F. Schlobohm Title: Owner/Operator

KANSAS CORPORATION COMMISSION  
RECEIVED  
01-05-2001  
JAN 05 2001  
CONSERVATION DIVISION  
WICHITA, KS

For KCC Use ONLY  
API # 15 - 167-23191-0000  
Conductor pipe required NONE feet  
Minimum surface pipe required 420' feet per Alt.   
Approved by: JK 1-8-2001  
This authorization expires: 7-8-2001  
(This authorization void if drilling not started within 6 months of effective date.)  
Spud date: \_\_\_\_\_ Agent: \_\_\_\_\_

- Remember to:
- File Drill Pit Application (form CDP-1) with Intent to Drill;
  - File Completion Form ACO-1 within 120 days of spud date;
  - File acreage attribution plat according to field proration orders;
  - Notify appropriate district office 48 hours prior to workover or re-entry;
  - Submit plugging report (CP-4) after plugging is completed;
  - Obtain written approval before disposing or injecting salt water.

2  
12  
15W

# IN ALL CASES PLOT THE INTENDED WELL ON THE PLAT BELOW

Plat of acreage attributable to a well in a prorated or spaced field

If the intended well is in a prorated or spaced field, please fully complete this side of the form. If the intended well is in a prorated or spaced field complete the plat below showing that the well will be properly located in relationship to other wells producing from the common source of supply. Please show all the wells and within 1 mile of the boundaries of the proposed acreage attribution unit for gas wells and within 1/2 mile of the boundaries of the proposed acreage attribution unit for oil wells.

API No. 15 - \_\_\_\_\_

Operator: Starr F. Schlobohm

Lease: Hoisington

Well Number: 1

Field: \_\_\_\_\_

Number of Acres attributable to well: 10 acre spacing

QTR / QTR / QTR of acreage: SE SW SW

Location of Well: County: Russell

330' feet from S N (circle one) Line of Section

990' feet from E W (circle one) Line of Section

Sec. 2 Twp. 12 S. R. 15  East  West



Is Section X Regular or \_\_\_\_\_ Irregular

If Section is Irregular, locate well from nearest corner boundary.

Section corner used: NE NW SE X SW

## PLAT

(Show location of the well and shade attributable acreage for prorated or spaced wells.)  
(Show footage to the nearest lease or unit boundary line.)

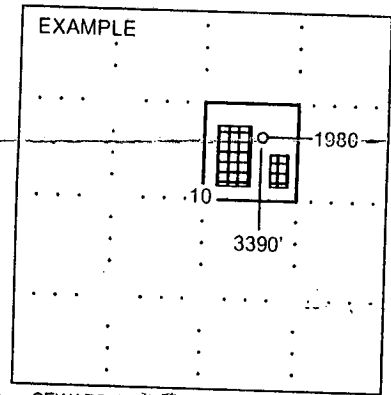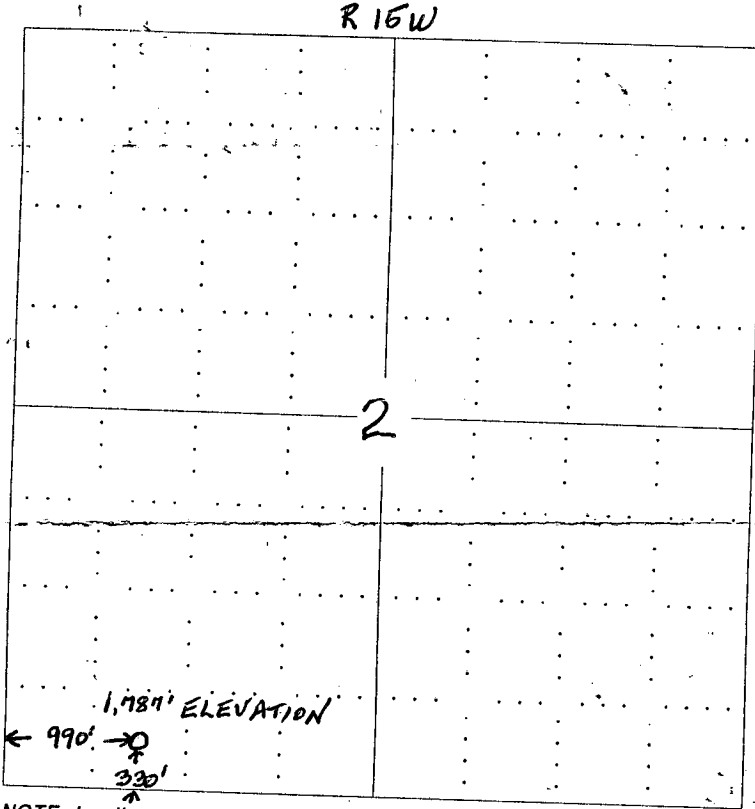

NOTE: In all cases locate the spot of the proposed drilling location.

In plotting the proposed location of the well, you must show:

1. The manner in which you are using the depicted plat by identifying section lines, i.e. 1 section, 1 section with 8 surrounding sections, 4 sections, etc.
2. The distance of the proposed drilling location from the section's south / north and east / west.
3. The distance to the nearest lease or unit boundary.
4. If proposed location is located within a prorated or spaced field a certificate of acreage attribution plat must be attached: (CO-7 for oil wells; CG-8 for gas wells).