

STATE OF KANSAS
STATE CORPORATION COMMISSION

WELL PLUGGING RECORD

OR


FORMATION PLUGGING RECORD

Strike out upper line
when reporting plug-
ging off formations.

Give All Information Completely
Make Required Affidavit
Mail or Deliver Report to:
Conservation Division
State Corporation Commission
800 Bitting Building
Wichita, Kansas

Russell County. Sec. 29 Twp. 12 Rge. 14 (E) W (W)
Location as "NE 1/4 NW 1/4 SW 1/4" or footage from lines SW SE NE
Lease Owner Crown Oil Company, Inc.
Lease Name Foster Well No. 2
Office Address Odell at 10th Street, Great Bend, Kansas
Character of Well (completed as Oil, Gas or Dry Hole) Dry
Date well completed November 21 19 49
Application for plugging filed November 21 19 49
Application for plugging approved November 21 19 49
Plugging commenced November 21 19 49
Plugging completed November 21 19 49
Reason for abandonment of well or producing formation

NORTH

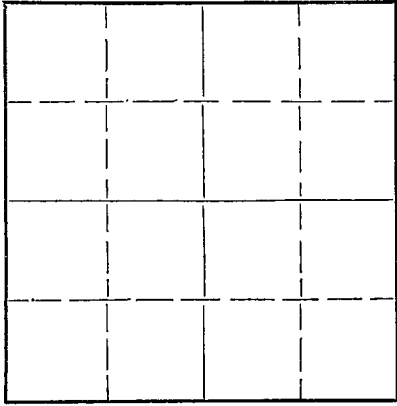

Locate well correctly on above
Section Plat

If a producing well is abandoned, date of last production 19
Was permission obtained from the Conservation Division or its agents before plugging was com-
menced?

Name of Conservation Agent who supervised plugging of this well
Producing formation Depth to top Bottom Total Depth of Well Feet
Show depth and thickness of all water, oil and gas formations.

OIL, GAS OR WATER RECORDS

CASING RECORD

| Formation | Content | From | To | Size | Put In | Pulled Out |
|-----------|---------|------|----|------|--------|------------|
| | | | | | | |
| | | | | | | |
Describe in detail the manner in which the well was plugged, indicating where the mud fluid was placed and the method or methods used in introducing it into the hole. If cement or other plugs were used, state the character of same and depth placed, from feet to feet for each plug set.

3122' to 250' Heavy Rotary Mud
Plug at 250' with 15 sacks cement
250' to 45' Heavy Rotary Mud
45' to Top Plugged with 10 sacks Portland cement

(If additional description is necessary, use BACK of this sheet)

Correspondence regarding this well should be addressed to Crown Oil Company, Inc.
Address Box 164, Great Bend, Kansas

STATE OF KANSAS, COUNTY OF BARTON, ss.
H. R. Buick (employee of owner) or (owner or operator) of the above-described well,
being first duly sworn on oath, says: That I have knowledge of the facts, statements, and matters herein contained and the log of the above-described well as filed and that the same are true and correct. So help me God.


(Signature) H. R. Buick

11-29-49 St. John, Kansas (Address)

SUBSCRIBED AND SWORN to before me this 25th day of November, 19 49

Edwina Elder Notary Public.

My commission expires September 21, 1953

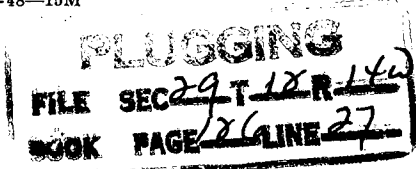

DRILLER'S LOG

COMPANY: CROWN OIL COMPANY, INC.
 CONTRACTOR: HILTON DRILLING COMPANY, INC.
 FARM NAME: FOSTER NO. 2

LOCATION: SW SE NE 29-12-14W
 Russell County, Kansas

ELEVATION: 1603 DF

COMMENCED: 11-8-49
 COMPLETED: 11-21-49

CASING USED: 8-5/8" at 673' with 550 sacks

| | |
|--------------------------------|------|
| Cellar | 5 |
| Surface Soil and Clay | 30 |
| Shale, Shells and Sand Streaks | 160 |
| Shale and Shells | 205 |
| Sand, Shells and Sand | 260 |
| Shale and Shells | 315 |
| Shale | 410 |
| Red Bed, Shale and Shells | 520 |
| Shale and Shells | 610 |
| Shale, Iron and Shells | 660 |
| Red Bed and Shale | 668 |
| Anhydrite | 676 |
| Anhydrite | 710 |
| Shale and Shells | 830 |
| Shale, Shells and Salt | 1300 |
| Shale and Shells | 1580 |
| Shale and Lime | 1935 |
| Shale and Shells | 2145 |
| Lime and Shale | 2255 |
| Shale and Shells | 2275 |
| Shale and Lime | 2360 |
| Shale and Shells | 2525 |
| Lime and Shale | 2600 |
| Lime | 3103 |
| Cherty Lime | 3122 |
| Total Depth | 3122 |

STATE OF KANSAS)
) SS
 COUNTY OF BARTON)

I, the undersigned, being duly sworn on oath, state that the above statement and log are true and a correct record and log of the well drilled at the location above described.

HILTON DRILLING COMPANY, INC.

By JAR Bunch

Subscribed and sworn to before me this 25th day of November, 1949.

Terry Peacock
 Notary Public

My commission expires June 13, 1951.

