


Give All Information Completely
Make Required Affidavit
Mail or Deliver Report to:
Conservation Division
State Corporation Commission
211 No. Broadway
Wichita, Kansas

WELL PLUGGING RECORD

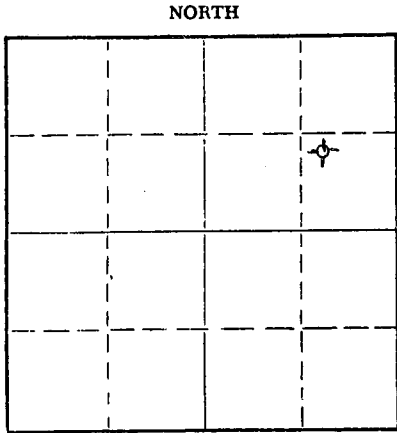

Locate well correctly on above
Section Plat

Russell County, Sec. 29 Twp. 12S Rge. (E) 14 (W)
Location as "NE/CNW%SW%" or footage from lines NW SE NE
Lease Owner KMH Oil Company
Lease Name Foster "C" Well No. 1
Office Address Box 348, Russell, Kansas
Character of Well (completed as Oil, Gas or Dry Hole) dry hole
Date well completed October 9 19 65
Application for plugging filed October 13 19 65
Application for plugging approved 19
Plugging commenced 8:30 a.m., October 9, 1965 19
Plugging completed 10:30 a.m., October 9, 1965 19
Reason for abandonment of well or producing formation dry hole

If a producing well is abandoned, date of last production 19
Was permission obtained from the Conservation Division or its agents before plugging was commenced? yes

Name of Conservation Agent who supervised plugging of this well Don Truan
Producing formation _____ Depth to top _____ Bottom _____ Total Depth of Well _____ Feet
Show depth and thickness of all water, oil and gas formations.

OIL, GAS OR WATER RECORDS

CASING RECORD

FORMATION	CONTENT	FROM	TO	SIZE	PUT IN	PULLED OUT
		0'	702'	8 5/8 "	702'	none

Describe in detail the manner in which the well was plugged, indicating where the mud fluid was placed and the method or methods used in introducing it into the hole. If cement or other plugs were used, state the character of same and depth placed, from _____ feet to _____ feet for each plug set.
Bottom plug at 350' with 1/4 sack hulls & 25 sx cement.
Top plug at 40' with 1/2 sack hulls & 10 sx cement.
2 sx cement in rat hole.

RECEIVED
OCT 14 1965

(If additional description is necessary, use BACK of this sheet)
Name of Plugging Contractor VAUGHAN DRILLING, INC.
Address BOX 825, Great Bend, Kansas


STATE OF KANSAS, COUNTY OF BARTON, ss.
Wayne Dobbs (employee of owner) or (owner or operator) of the above-described well, being first duly sworn on oath, says: That I have knowledge of the facts, statements, and matters herein contained and the log of the above-described well as filed and that the same are true and correct. So help me God.

(Signature) Wayne Dobbs
1060 Warner Road, Great Bend, Kansas
(Address)

SUBSCRIBED AND SWORN TO before me this 13th day of October, 19 65

My commission expires August 27, 1969

Delores Strecker
Delores Strecker Notary Public.

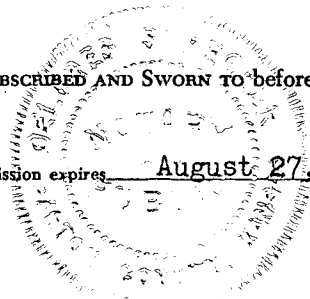

WELL LOG

COMPANY KMH Oil Company
 CONTRACTOR Vaughan Drilling, Inc.
 FARM #1 Foster "C"
 LOCATION NW SE NE of sec. 29-12-14W
 Russell County, Kansas
 ELEVATION 1624 K.B.
 SURFACE PIPE 8 5/8" set @ 702 ft. with 350 sx posmix sunset.
 PRODUCTION D & A
 COMMENCED 10-1-65
 COMPLETED 10-9-65

<u>FORMATION</u>	<u>DEPTH</u>
Sandstone	40
Shale	185
Sandstone & Hard Sand w/Shale Streaks	250
Red Bed	688
Anhydrite	726
Red Bed & Shale	830
Shale & Shells	1315
Limestone & Shale	1680
Limestone	1840
Limestone & Shale	2528
Limestone & Shale	3136
Chert	3162
Arbuckle	3170
Rotary Total Depth	3170

RECEIVED
STATE CORPORATION COMMISSION

OCT 14 1965

CONSERVATION DIVISION
Wichita, Kansas

FORMATION TOPS

Anhydrite	668 (+ 956)
Indian Cave	2146 (- 522)
Grandhaven	2190 (- 566)
Tarkio	2266 (- 642)
Topeka	2528 (- 904)
Heebner	2752 (-1128)
Toronto	2774 (-1150)
Lansing	2806 (-1182)
Cherty Conglomerate	3128 (-1504)
Arbuckle	3162 (-1538)
Rotary Total Depth	3170 (-1546)

A F F I D A V I T

STATE OF KANSAS, COUNTY OF BARTON, SS:

I, Wayne Dobbs, of the VAUGHAN DRILLING, INC., being first duly sworn on oath, state; that I have knowledge of the facts, statements and matters herein contained and that the same are true and correct.

Wayne Dobbs
Wayne Dobbs,

Subscribed and sworn to before me this 13th day of October, 1965.

Delores Strecker
Delores Strecker, Notary Public



My Commission Expires Aug. 27, 1969