

WELL PLUGGING RECORD

OR


FORMATION PLUGGING RECORD

Strike out upper line when reporting plugging off formations.

Give All Information Completely
Make Required Affidavit
Mail or Deliver Report to:
Conservation Division
State Corporation Commission
800 Bittling Building
Wichita, Kansas

Russell County. Sec. 30 Twp. 12S Rge. (E) 14 (W)
Location as "NE $\frac{1}{4}$ NW $\frac{1}{4}$ SW $\frac{1}{4}$ " or footage from lines NE $\frac{1}{4}$ NE $\frac{1}{4}$ SW $\frac{1}{4}$
Lease Owner Sharon Drilling Company, Inc.
Lease Name Krug Well No. 1
Office Address 352 N. Broadway, Wichita 2, Kansas.
Character of Well (completed as Oil, Gas or Dry Hole) Dry Hole
Date well completed April 20 19 46
Application for plugging filed April 25 (Field 4/21/46) 19 46
Application for plugging approved April 29 19 46
Plugging commenced April 22 19 46
Plugging completed April 22 19 46
Reason for abandonment of well or producing formation Dry

Range 14 NORTH West

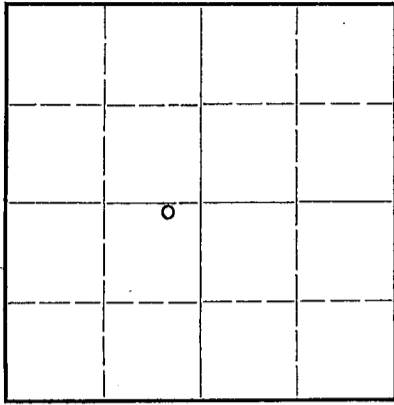

Locate well correctly on above Section Plat

If a producing well is abandoned, date of last production 19
Was permission obtained from the Conservation Division or its agents before plugging was commenced? Yes - in field

Name of Conservation Agent who supervised plugging of this well H. W. KERR
Producing formation Depth to top Bottom Total Depth of Well 3268 Feet
Show depth and thickness of all water, oil and gas formations.

OIL, GAS OR WATER RECORDS

CASING RECORD

Formation	Content	From	To	Size	Put In	Pulled Out
Sand	Water	20	50	10 3/4	160	None
	Appears Water bearing	3210	3268		None	

Describe in detail the manner in which the well was plugged, indicating where the mud fluid was placed and the method or methods used in introducing it into the hold. If cement or other plugs were used, state the character of same and depth placed, from feet to feet for each plug set.

3268 to 160 Filled with heavy mud
160 Set plug
160 to 70 Pumped in 25 sack cement
70 to 15 Filled with heavy mud
15 Set plug
15 to 6 Pumped in 10 sacks cement

30 12 14W
52 6

MAY 1 - 1946 05-04-46

(If additional description is necessary, use BACK of this sheet)

Correspondence regarding this well should be addressed to Sharon Drilling Company, Inc.
Address 352 N. Broadway, Wichita 2, Kansas,

STATE OF KANSAS, COUNTY OF SEDGWICK, ss.
M. S. DAVIS (employee of owner) or (owner) of the above-described well,

being first duly sworn on oath, says: That I have knowledge of the facts, statements, and matters herein contained and the log of the above-described well as filed and that the same are true and correct. So help me God.

(Signature) M. S. Davis

352 N. Broadway (Address)

SUBSCRIBED AND SWORN TO before me this 3rd day of May, 1946

My commission expires Sept 16 - 1948 Notary Public.

Sharon Drilling Company, Inc., Et al,
#1 Krug
Spudded: April 5, 1946.
Rotary Completion: April 20, 1946.
Rotary Tool Depth: 3268

NE^c NE⁴ SW 30-12S-14W
Russell County, Kansas,
Elevation: 1647
I.P. - D & A

CASING RECORD

160' of 10 3/4" spiral weld surface casing cemented w/150 Sacks cement

DRILLERS LOG

Clay	0' to 20'	Sand	1725'
Sand	50'	Broken Lime	2110'
Red Rock	160'	Shale and Shells	2665'
Shale	185'	Lime	2835'
Sand	215'	Red Shale	2848'
Shale	225'	Lime	3149'
Sand and Iron	256'	Conglomerate	3193'
Shale and Shells	315'	Lime	3210'
Sand and Shale	355'	Arbuckle Lime	3240'
Shale	375'	Lime	3268'
Sand	390'		
Shale and Shells	470'	T.D. Corrected to D. F.	3266'
Red Rock	705'	Dry and Abandoned	
Shale	712'		
Anhydrite	750'		
Red Rock	840'		
Shale	900'		
Shale and Shells	1290'		
Shale-Shells and Salt	1400'		
Broken Lime	1700'		

GEOLOGICAL TOPS

Lansing-Kansas City	2846 D.F.
Cherty Conglomerate	3147 D.F.
Arbuckle	3191 D.F.

