

STATE OF KANSAS  
STATE CORPORATION COMMISSION

Give All Information Completely  
Make Required Affidavit  
Mail or Deliver Report to:  
Conservation Division  
State Corporation Commission  
212 North Market, Insurance Bldg.  
Wichita, Kansas

WELL PLUGGING RECORD

Russell County. Sec. 30 Twp. 12 Rge. -(E) 14(W)

Location as "NE/CNW/SW" or footage from lines SE NW NW

Lease Owner Rudy Herman Oil Operations

Lease Name Krug Well No. 1

Office Address Box 348 Russell, Kansas

Character of Well (completed as Oil, Gas or Dry Hole) Dry hole

Date well completed April 16 1960

Application for plugging filed April 22 1960

Application for plugging approved \_\_\_\_\_ 19\_\_\_\_


Plugging commenced 9:42 p.m. April 16 1960

Plugging completed 3:15 p.m. " " 1960

Reason for abandonment of well or producing formation dry hole

If a producing well is abandoned, date of last production \_\_\_\_\_ 19\_\_\_\_

Was permission obtained from the Conservation Division or its agents before plugging was commenced? yes

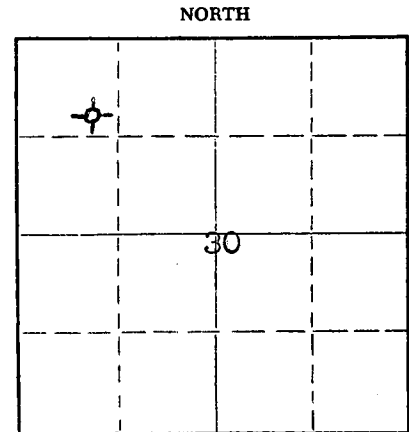

Locate well correctly on above Section Plat

Name of Conservation Agent who supervised plugging of this well Mr. Don Truan

Producing formation \_\_\_\_\_ Depth to top \_\_\_\_\_ Bottom \_\_\_\_\_ Total Depth of Well 3130 Feet

Show depth and thickness of all water, oil and gas formations.

OIL, GAS OR WATER RECORDS

CASING RECORD

FORMATION	CONTENT	FROM	TO	SIZE	PUT IN	PULLED OUT
				8 5/8"	218'	none

Describe in detail the manner in which the well was plugged, indicating where the mud fluid was placed and the method or methods used in introducing it into the hole. If cement or other plugs were used, state the character of same and depth placed, from \_\_\_\_\_ feet to \_\_\_\_\_ feet for each plug set.

Hole plugged by Halliburton with 100 sacks of Posmix pumped into top of surface pipe.

RECEIVED  
STAT. CORPORATION COMMISSION  
APR 29 1960 04-29-60  
CONSERVATION DIVISION  
Wichita, Kansas

(If additional description is necessary, use BACK of this sheet)

Name of Plugging Contractor Triangle Drilling, Inc.  
Address Box 287 Russell, Kansas

STATE OF Kansas, COUNTY OF Barton, ss.  
Donald D. Vaughan (employee of owner) or ~~(owner or operator)~~ of the above-described well, being first duly sworn on oath, says: That I have knowledge of the facts, statements, and matters herein contained and the log of the above-described well as filed and that the same are true and correct. So help me God.

(Signature) Donald D. Vaughan  
Box 619 Great Bend, Kansas  
(Address)

SUBSCRIBED AND SWORN TO before me this 22 n. d. day of April, 1960

My commission expires May 11, 1963  
Donna Lea Foelgner  
Donna Lea Foelgner Notary Public.



WELL LOG

OPERATOR Rudy Herman Oil Operations  
 CONTRACTOR Triangle Drilling, Inc.  
 FARM #1 Krug  
 LOCATION SE NW NW of Section 30-12-14W  
 Russell County, Kansas  
 ELEVATION 1637 KB  
 SURFACE PIPE 8 5/8" cemented @ 218\* w/125 sacks HA5 cement  
 PRODUCTION D & A  
 COMMENCED 4-6-60  
 COMPLETED 4-16-60

<u>FORMATION</u>	<u>DEPTH</u>
Surface clay, sand & post rock	40
Clay & shale	143
Hard sand & sandstone	206
Hard sand	218
Sandstone	245
Shale	255
Sand and shale streaks	380
Red bed	700
Anhydrite	736
Shale & shells	1360
Lime & shale	1590
Limestone	1865
Lime & shale	2552
Limestone	3050
Lime & shale	3130

**RECEIVED**  
 STATE CORPORATION COMMISSION  
 APR 29 1960  
 CONSERVATION DIVISION  
 Wichita, Kansas

FORMATION TOPS

Anhydrite	700 (✓ 937) driller*s
Topeka	2552 (- 915)
Lansing	2829 (-1192)
RTD	3130 (-1493)

A F F I D A V I T

STATE OF KANSAS, COUNTY OF BARTON, SS.

I, Donald D. Vaughan, of the TRIANGLE DRILLING, INC., being first duly sworn on oath, state; That I have knowledge of the facts, statements and matters herein contained and that the same are true and correct.

*Donald D. Vaughan*  
 Donald D. Vaughan

Subscribed and sworn to before me this 23rd day of April, 1960.

My commission expires: May 11, 1963.

*Donna Lea Foelgner*  
 Donna Lea Foelgner, Notary Public