


Give All Information Completely
Make Required Affidavit
Mail or Deliver Report to:
Conservation Division
State Corporation Commission
212 No. Market
Wichita, Kansas

WELL PLUGGING RECORD

Russell County, Sec. 31 Twp. 12 Rge. 14 (E) W(W)
Location as "NE/CNW/SW" or footage from lines NE NE SW
Lease Owner E. E. McCully Burns Oil Co ANB KCC
Lease Name Kingsley Well No. 1
Office Address Russell, Kansas
Character of Well (completed as Oil, Gas or Dry Hole)
Date well completed 19__
Application for plugging filed 19__
Application for plugging approved 19__
Plugging commenced 10/26 19 72
Plugging completed 11/17 19 72
Reason for abandonment of well or producing formation
If a producing well is abandoned, date of last production 19__
Was permission obtained from the Conservation Division or its agents before plugging was commenced? Yes

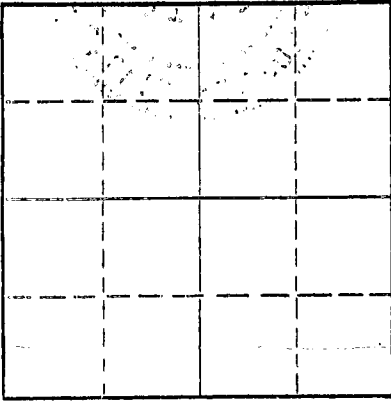

Name of Conservation Agent who supervised plugging of this well Donald Truan
Producing formation _____ Depth to top _____ Bottom _____ Total Depth of Well 3272' Feet
Show depth and thickness of all water, oil and gas formations. 3265 ANB KCC

OIL, GAS OR WATER RECORDS CASING RECORD

FORMATION	CONTENT	FROM	TO	SIZE	PUT IN	PULLED OUT
				5 1/2"		2308'

Describe in detail the manner in which the well was plugged, indicating where the mud fluid was placed and the method or methods used in introducing it into the hole. If cement or other plugs were used, state the character of same and depth placed, from _____ feet to _____ feet for each plug set.
Sand from 2678' to 2650', 5 sacks of cement from 2650' to 2620'.
Pumped by Allied Cementing Co.-20 sacks of gel mud & 100 sacks of cement to base of cellar.

RECEIVED
STATE CORPORATION COMMISSION
NOV 28 1972
CONSERVATION DIVISION
Wichita, Kansas
11-28-72

(If additional description is necessary, use BACK of this sheet)
Name of Plugging Contractor Glenn & Smith Pipe Pulling Co.
Address Box 156 Ellinwood, Kansas 67526

STATE OF Kansas, COUNTY OF Russell, ss.
E. E. McCully (employee of owner) or (owner or operator) of the above-described well, being first duly sworn on oath, says: That I have knowledge of the facts, statements, and matters herein contained and the log of the above-described well as filed and that the same are true and correct. So help me God.

(Signature) E. E. McCully
Star Route, Russell, Ks.
(Address)

Subscribed and sworn to before me this 27th day of November, 19 72
My commission expires May 5th, 1974
Silvia Newton
Notary Public.




Company- Tomlinson & Kathol
Farm- Kingsley No.1

SEC. 31 T. 12 R. 14W
180'E of NE NE SW

Total Depth. 3267
Comm. 8-18-64 Comp. 8-26-64
Shot or Treated.
Contractor Mayfield-Smith Drlg. Inc.
Issued. 11-28-64

County Russell
KANSAS

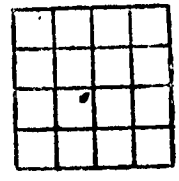

Elevation. 1801 KB

Production. 48 BOPD 20% wtr.

CASING:

8 5/8" 220' cem w/125 sx
5 1/2" 3267 cem w/125 sx

Figures Indicate Bottom of Formations.

Sand and Shale	220
Shale, Shells & Sand	565
Shale & Shells	835
Anhydrite Lime	895
Shale & Shells	990
Shale	1180
Lime & Shale	1270
Shale & Shells	1515
Shale & Lime	1710
Lime & Shale	2765
Lime	3246
Lime & Arbuckle lime	3264
Arbuckle	3267
TOPS	
Tarkio	2440
Topeka	2703
Heebner	2927
Lansing	2980
Base K.C.	3231
Arbuckle	3261

RECEIVED
STATE CORPORATION COMMISSION
JAN 19 1973
CONSERVATION DIVISION
Wichita, Kansas