


STATE OF KANSAS
STATE CORPORATION COMMISSION

WELL PLUGGING RECORD

Give All Information Completely
Make Required Affidavit
Mail or Deliver Report to:
Conservation Division
State Corporation Commission
211 No. Broadway
Wichita, Kansas

NORTH

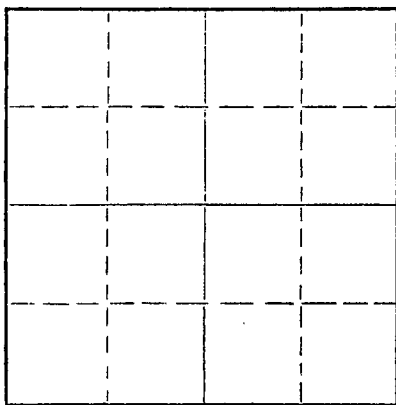

Locate well correctly on above
Section Plat

Russell County. Sec. 31 Twp. 12 Rge. 14 (E) W (W)
Location as "NE/CNW/SW" or footage from lines SW SE NW
Lease Owner Fred J. Haynes
Lease Name Krug Well No. 1
Office Address Bldg. & Loan Bldg., Russell, Kansas
Character of Well (completed as Oil, Gas or Dry Hole) D & A
Date well completed May 17, 1958 19
Application for plugging filed May 17 19 58
Application for plugging approved " " 19 "
Plugging commenced " " 19 "
Plugging completed " " 19 "
Reason for abandonment of well or producing formation No Commercial Production

If a producing well is abandoned, date of last production _____ 19____
Was permission obtained from the Conservation Division or its agents before plugging was commenced? Yes

Name of Conservation Agent who supervised plugging of this well Don Truan Russell, Kansas
Producing formation _____ Depth to top _____ Bottom _____ Total Depth of Well 3270 Feet
Show depth and thickness of all water, oil and gas formations.

OIL, GAS OR WATER RECORDS

CASING RECORD

FORMATION	CONTENT	FROM	TO	SIZE	PUT IN	PULLED OUT
				8 5/8"	250	None

Describe in detail the manner in which the well was plugged, indicating where the mud fluid was placed and the method or methods used in introducing it into the hole. If cement or other plugs were used, state the character of same and depth placed, from 230 feet to 35 feet for each plug set.
Set plug at 230' and cemented with 1/3 sack hulls and 25 sacks cement, filled hole with mud to 35', set plug and cemented with 10 sacks cement.

05-26-58

(If additional description is necessary, use BACK of this sheet)

Name of Plugging Contractor Haynes Drilling Company
Address Bldg. & Loan Bldg., Russell, Kansas


STATE OF Kansas, COUNTY OF Russell, ss.
Fred J. Haynes (employee of owner) or (owner or operator) of the above-described well, being first duly sworn on oath, says: That I have knowledge of the facts, statements, and matters herein contained and the log of the above-described well as filed and that the same are true and correct. So help me God.

(Signature) [Signature]
Russell, Kansas (Address)

SUBSCRIBED AND SWORN TO before me this 21st day of May, 19 58

[Signature]
Notary Public.

My commission expires January 17, 1961.

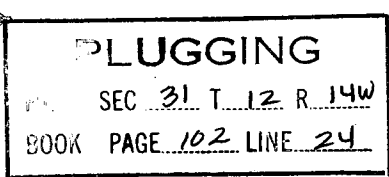

DRILLERS LOG
 Plug # 1
 SW SE NW 31-12-14
 Russell County, Kansas

Commenced: May 10, 1958 Casing: 8 5/8" at 250' w/150lbs

Completed: May 17, 1958 I. P. - D & A

Operator: Fred J. Haynes
 Bldg. & Loan Bldg.
 Russell, Kansas

Contractor: Haynes Drilling Company
 Russell, Kansas

Formation:

Post Rock & Clay	50
Shale	70
Shale & Sand	195
Shale	330
Sand & Shale	530
Redbed	855
Anhydrite	855-888
Shale & Shells	1223
Salt & Shale	1450
Shale & Lime	1825
Lime	2065
Lime & Shale	2585
Lime & Shale	2815
Lime	3045
Conglomerate & TD	3270

I hereby certify that the above is true and correct
 to the best of my knowledge.

Ralph L. Schulte

PLUGGING
SEC. 31 T. 12 R. 14W
BOOK PAGE 102 LINE 24