

Notice: Fill out COMPLETELY and return to Conservation Division at the address below within 60 days from plugging date

KANSAS CORPORATION COMMISSION OIL & GAS CONSERVATION DIVISION

Form CP-4 December 2003 Type or Print on this Form Form must be Signed All blanks must be Filled

WELL PLUGGING RECORD

K.A.R. 82-3-117

Lease Operator: Presco Western, LLC

Address: 5665 FLATIRON PARKWAY BOULDER CO 80301

Phone: 303-305-1163 Operator License #: 32309

Type of Well: Oil Docket #: (Oil, Gas D&A, SWD, ENHR, Water Supply Well, Cathodic, Other) (If SWD or ENHR)

The plugging proposal was approved on: 5/19/2009 (Date)

by: Ken Jehlik (KCC District Agent's Name)

Is ACO-1 filed? [X] Yes [] No If not, is well log attached? [] Yes [] No

Producing Formation(s): List All (If needed attach another sheet)

Depth to Top: Bottom: T.D.

Depth to Top: Bottom: T.D.

Depth to Top: Bottom: T.D.

API Number: 15- 187-20871-0000

Lease Name: Kaylee Brooke

Well Number: 1-35

Spot Location (QQQQ): - - NE - NE

810 Feet from [X] North / [] South Section Line

660 Feet from [X] East / [] West Section Line

Sec. 35 Twp. 29 S. R. 40 [] East [X] West

County: Stanton

Date Well Completed: 2/19/1997

Plugging Commenced: 5/21/2009

Plugging Completed: 5/22/2009

Show depth and thickness of all water, oil and gas formations.

Table with columns: Oil, Gas or Water Records (Formation, Content) and Casing Record (Surface Conductor & Production) (From, To, Size, Put in, Pulled out)

Describe in detail the manner in which the well was plugged, indicating where the mud fluid was placed and the method or methods used in introducing it into the hole.

1st Plug: CIBP @ 5,325' w/ 2 SX cmt. 2nd Plug: 20 SX cmt @ 3,857'. 3rd Plug: 20 SX cmt @ 2,963'. 4th Plug: 50 SX cmt @ 1,850'. 5th Plug: 50 SX cmt from 678' to surface. 6th Plug: Dumped 4.5 SX cmt down surface csg.

*All cmt used is 60/40 POZ.

Name of Plugging Contractor: Basic Energy License #: 34069

Address: PO Box 10460, Midland, TX 79702

Name of Party Responsible for Plugging Fees: Presco Western, LLC

State of Colorado County, Boulder, ss.

Keli Kowalski (Employee of Operator) or (Operator) on above-described well, being first duly sworn on oath, says: That I have knowledge of the facts statements, and matters herein contained, and the log of the above-described well as filed and the same are true and correct, so help me God.

RECEIVED MAY 28 2009


KCC WICHITA

(Signature) Keli Kowalski

(Address) 5665 Flatiron Parkway, Boulder, CO 80301


SUBSCRIBED and SWORN TO before me this 27th day of May, 2009

Notary Public Signature My Commission Expires: 2-12-2011

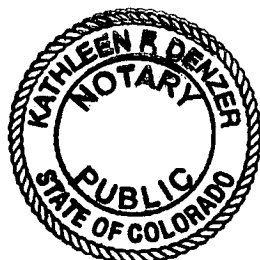

Handwritten initials/signature

KAYLEE BROOKS 1-35
15-187-20871

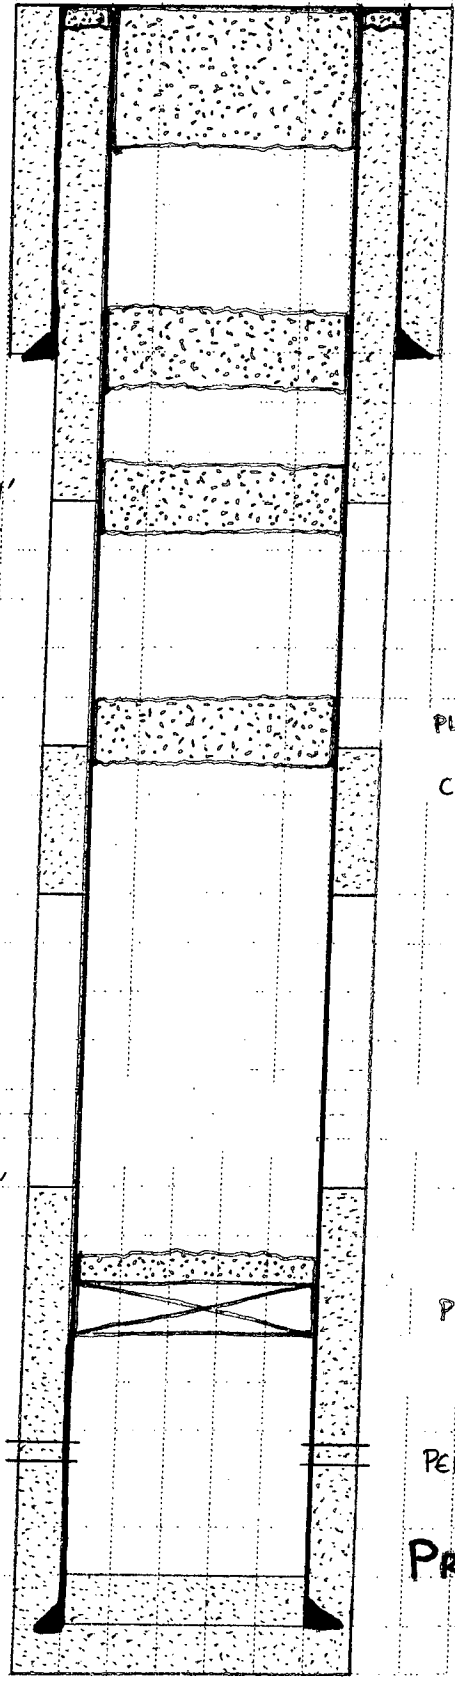

PLUGGING COMMENCED:
5/21/09

PLUGGING COMPLETED:
5/22/09

COMPANY REP:
CLINT ANDREWS

PLUGGING APPROVED:
VERBALLY ON 5/19/09
BY KEN JEHLIK (KCC)

PLUGGING CONTRACTOR:
BASIC ENERGY

DV TOOL @ 2,901'
CMT'D TO SURFACE
W/ 435 SXS

PLUG #6 DUMPED 4.5 SXS 60/40 P02 CMT
DOWN SURFACE CASING

PLUG #5 50SXS 60/40 P02 CMT FROM
678' TO SURFACE

SURFACE CSG

8 5/8" 24# J-55 @ 1,792'
PLUG #4 50 SXS 60/40 P02 CMT @ 1,850'
PLUG #3 20 SXS 60/40 P02 CMT @ 2,963'

PLUG #2 20 SXS 60/40 P02 CMT @ 3,857'

CSG LEAK FROM 3,863' - 4,115'
SQZ'D W/ 150 SXS CMT
(STILL LEAKING)

RECEIVED
MAY 28 2009
KCC WICHITA

PLUG #1 CIBP @ 5,325' W/ 2 SXS CMT ON TOP

PERFS 5,596' - 5,612' (ST. LOUIS)

PRODUCTION CSG

4 1/2" 10.5# J-55 @ 5,708'